

MISSISSIPPI DEPARTMENT OF NATURAL RESOURCES

Bureau of Land and Water Resources

Southport Mall

P.O. Box 10631

Jackson, Mississippi 39209

WATER WELL DRILLERS LOG

HANCOCK  
K 25 23

5-30-1984 date well completed  
Wood Well Dg firm name  
Hancock county well located

LANDOWNER: Glenn Alexander  
Box 383A  
Bay St. Louis, ms.  
(mailing address)

WELL LOCATION:  
sec 22 T 4 N R 13 E 14  
5 miles N/W of B.S.L.  
(distance) (direction) (nearest town)

WELL PURPOSE: Home  
(home, irrigation, municipal, industrial)

WELL COMPLETION DATA:

(1) diameter (inches) 2"  
(2) total depth (feet) 400  
(3) static water level (feet) 1 below top of ground  
(4) casing PVC 390 (material) (depth)  
If telescope see back.  
(5) screen 10' (length) (depth to top)  
2" PVC (size) (material)  
(6) pump orwin (HP) (yield gpm)  
(type power)  
(7) electric log NO (yes or no)  
N/A (organization running log)  
(8) how well bottom plugged BWU

description of formations encountered	from	to
	fill - clay	0
sd	22	55
clay	55	105
sd	105	125
clay - silt	125	154
sd	154	167
clay - silt	167	256
sd	256	290
clay - silt	290	365
sd	365	400

DEPT OF NATURAL RESOURCES  
BUREAU OF LAND & WATER RESOURCES


JUL 20 1984

RECEIVED

DRILLERS REMARKS: N/A

If well telescopes please sketch and show depths.

GROUND LEVEL

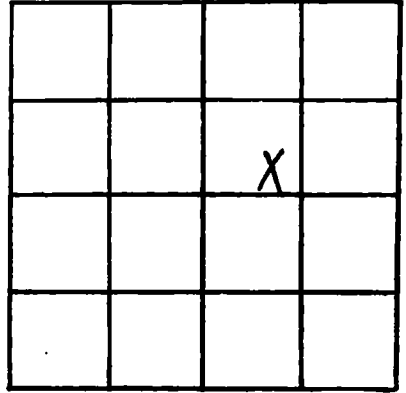

SECTION 22

Please indicate well location X.

ADDITIONAL INFORMATION

If more than one screen,  
show locations of each on sketch.