

HANCOCK
R 25 26

MISSISSIPPI DEPARTMENT OF NATURAL RESOURCES
Bureau of Land and Water Resources
Southport Mall
P.O. Box 10631
Jackson, Mississippi 39209
WATER WELL DRILLERS LOG

5-31-1984 date well completed
Ward Well Dlg. firm name
Hancock county well located

LANDOWNER: Monte Sheenway
Pt. 4, Box 384A
Bay St. Louis, ms
(mailing address)

WELL LOCATION:
sec. 22 T 8 N R 13 E
4 1/2 miles N/W of B.S.L.
(distance) (direction) (nearest town)

WELL PURPOSE: Home
(home, irrigation, municipal, industrial)

WELL COMPLETION DATA:

(1) diameter (inches) 2"
(2) total depth (feet) 335'
(3) static water level (feet) 1 below top of ground.
(4) casing PVC, 325.
(size) (material) (depth)
If telescope see back.
(5) screen 10' (length) (depth to top)
2" PVC (size) (material)
(6) pump owner (HP) (yield gpm)
(type power)
(7) electric log no (yes or no)
N/A (organization running log)
(8) how well bottom plugged BWV

description of formations encountered	from	to
fill - clay	0	15
sd	15	47
clay	47	75
sd	75	88
clay	88	104
sd	104	116
clay - silt	116	158
sd	158	166
clay - silt	166	264
sd	264	288
clay - silt	288	306
sd	306	335

DEPT. OF NATURAL RESOURCES
BUREAU OF LAND & WATER RESOURCES


JUL 20 1984

RECEIVED

DRILLERS REMARKS: N/A

If well telescopes please sketch and show depths.

GROUND LEVEL

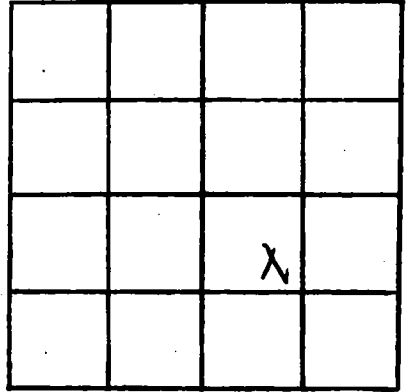

SECTION 22

Please indicate well location X.

ADDITIONAL INFORMATION

If more than one screen,
show locations of each on sketch.