

**MISSISSIPPI DEPARTMENT OF NATURAL RESOURCES**  
**Bureau of Land and Water Resources**  
 Southport Mall  
 P.O. Box 10631  
 Jackson, Mississippi 39209  
**WATER WELL DRILLERS LOG**

Hancock  
K2528

6-8-

1984 Ward Well Dlg.

Hancock

date well completed

firm name

county well located

LANDOWNER: Sandra Davis  
Sack St.  
Boy St. Louis, ms.  
 (mailing address)

description of formations encountered

from to

WELL LOCATION:  
 sec 10 T 8 N R 13 E 14  
7 miles N/W of Warland  
 (distance) (direction) (nearest town)

<u>fill - clay</u>	<u>0</u>	<u>18</u>
<u>sd</u>	<u>18</u>	<u>48</u>
<u>clay w/ shell</u>	<u>48</u>	<u>84</u>
<u>sd</u>	<u>84</u>	<u>95</u>
<u>clay</u>	<u>95</u>	<u>106</u>
<u>sd</u>	<u>106</u>	<u>121</u>
<u>clay - silt</u>	<u>121</u>	<u>145</u>
<u>concl sd</u>	<u>145</u>	<u>168</u>

WELL PURPOSE: drill  
 (home, irrigation, municipal, industrial)

WELL COMPLETION DATA:

- (1) diameter (inches) 2"
- (2) total depth (feet) 168
- (3) static water level (feet) 2 <sup>below</sup> <sub>above</sub> top of ground.
- (4) casing PVC 158  
 (material) (depth)  
 (size) If telescope see back.
- (5) screen 10' -  
 (length) (depth to top)  
2" PVC  
 (size) (material)
- (6) pump Ortiz -  
 (HP) (yield gpm)  
 (type power)
- (7) electric log NO  
 (yes or no)  
N/A  
 (organization running log)
- (8) how well bottom plugged BWV

DRILLERS REMARKS: N/A


DEPT. OF NATURAL RESOURCES  
 BUREAU OF LAND & WATER RESOURCES

AUG 8 1984

**RECEIVED**

If well telescopes please sketch and show depths.

GROUND LEVEL

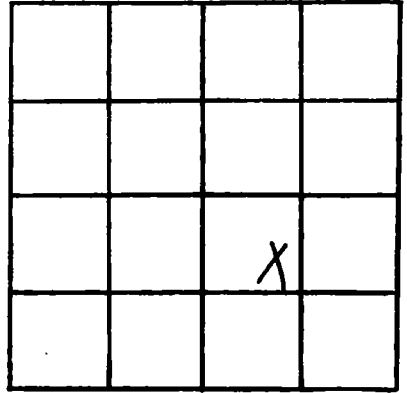

SECTION \_\_\_\_\_

Please indicate well location X.

ADDITIONAL INFORMATION

If more than one screen, show locations of each on sketch.