

MISSISSIPPI DEPARTMENT OF NATURAL RESOURCES

Bureau of Land and Water Resources

Southport Mall

P.O. Box 10631

Jackson, Mississippi 39209

WATER WELL DRILLERS LOG

HANCOCK
K2529

1-10-84 19 Medico Wood Works Hancock
date well completed firm name county well located

LANDOWNER: Oscar Breland
1543 Waveland Ave
Waveland, Miss.
(mailing address)

WELL LOCATION:
sec 19 T 8 N R 13 E
2 miles NW of BSL
(distance) (direction) (nearest town)

WELL PURPOSE: home
(home, irrigation, municipal, industrial)

WELL COMPLETION DATA:

- (1) diameter (inches) 2"
- (2) total depth (feet) 480'
- (3) static water level (feet) 60' below above top of ground
- (4) casing sch 40, 480'
(material) (depth)
- _____ if telescope see back.
(size)
- (5) screen 10', 470'
(length) (depth to top)
2", sch 50
(size) (material)
- (6) pump 1 8
(HP) (yield gpm)
eee
(type power)
- (7) electric log _____
(yes or no)

(organization running log)
- (8) how well bottom plugged Seal

description of formations encountered	from	to
Sand	0	60
Mud	60	160
Sand & GRAVEL	160	180
Mud	180	200
Mud & Sand	200	240
Mud	240	340
Mud & Sand	340	380
Mud & Sand	380	400
Mud	400	420
Sand	420	480

DEPT. OF NATURAL RESOURCES
BUREAU OF LAND & WATER RESOURCES


JAN 10 1984

RECEIVED

DRILLERS REMARKS:

If well telescopes please sketch and show depths.

GROUND LEVEL

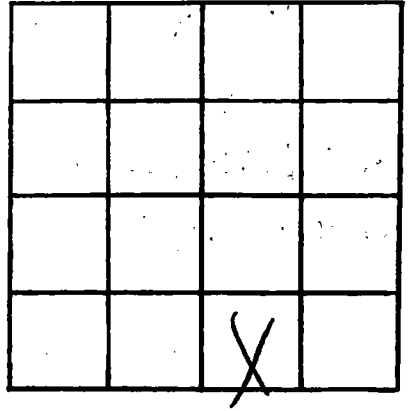

SECTION 19

Please indicate well location X.

ADDITIONAL INFORMATION

If more than one screen,
show locations of each on sketch.