

MISSISSIPPI DEPARTMENT OF NATURAL RESOURCES

Bureau of Land and Water Resources

Southport Mall

P.O. Box 10631

Jackson, Mississippi 39209

WATER WELL DRILLERS LOG

Hancock
K253D

6-22

1984 Ward Well Dr.

Hancock

date well completed

firm name

county well located

LANDOWNER: Emmett Curry

Rt. 4, Box 377A

Bay St. Louis, Miss.
(mailing address)

WELL LOCATION:

sec. 27 T-8 N R-13 E 14

4 miles N/W of B.S.L.
(distance) (direction) (nearest town)

WELL PURPOSE: Home

(home, irrigation, municipal, industrial)

WELL COMPLETION DATA:

(1) diameter (inches) 2"
(2) total depth (feet) 330

(3) static water level (feet) 1 below top of ground

(4) casing PVC, 320
(material) (depth)

- if telescope see back.
(size)

(5) screen 10', -
(length) (depth to top)

2", PVC
(size) (material)

(6) pump -, -
(HP) (yield gpm)

-
(type power)

(7) electric log NO
(yes or no)

N/A
(organization running log)

(8) how well bottom plugged BWV

DRILLERS REMARKS: N/A

description of formations encountered

from	to
0	18
18	47
48	76
76	84
84	102
102	116
116	142
142	165
165	276
276	330

Clay
sd
Clay
sd
Clay
sd
Clay - Silt
sd
Clay - Silt
sd


DEPT. OF NATURAL RESOURCES
BUREAU OF LAND & WATER RESOURCES

AUG 3 1984

RECEIVED

If well telescopes please sketch and show depths.

GROUND LEVEL

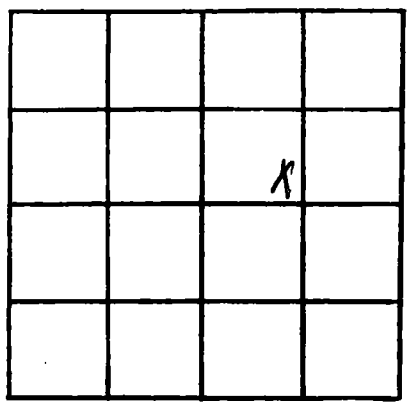

SECTION 27

Please indicate well location X.

ADDITIONAL INFORMATION

A series of horizontal lines for writing additional information, starting below the 'ADDITIONAL INFORMATION' header and extending to the bottom of the page.

If more than one screen, show locations of each on sketch.