

MISSISSIPPI DEPARTMENT OF NATURAL RESOURCES

Bureau of Land and Water Resources

Southport Mall

P.O. Box 10631

Jackson, Mississippi 39209

WATER WELL DRILLERS LOG

Hancock
K2581

6-25
date well completed

1984 Ward Well Drg.
firm name

Hancock
county well located

LANDOWNER: Charles H. Burns

19 Ave St.

Bay St. Louis mo.
(mailing address)

WELL LOCATION:

sec. 22 T-8 N R-13 E 14

4 miles N/W of B.S.L.
(distance) (direction) (nearest town)

WELL PURPOSE: Home
(home, irrigation, municipal, industrial)

WELL COMPLETION DATA:

(1) diameter (inches) 2"

(2) total depth (feet) 415

(3) static water level (feet) 1 below top of ground

(4) casing PVC, 405
(material) (depth)

- if telescope see back.
(size)

(5) screen 10', -
(length) (depth to top)

2", PVC
(size) (material)

(6) pump - -
(HP) (yield gpm)

-
(type power)

(7) electric log NO
(yes or no)

N/A
(organization running log)

(8) how well bottom plugged BWV

DRILLERS REMARKS: N/A

description of formations encountered	from	to
Clay	0	16
gsd	16	44
Clay	44	76
gsd	76	85
Clay	85	105
gsd	105	114
Clay - silt	114	152
gsd	152	168
Clay - silt	168	276
gsd	276	315
Clay - silt	315	386
gsd	386	415


DEPT. OF NATURAL RESOURCES
BUREAU OF LAND & WATER RESOURCES

AUG 2 1984

RECEIVED

If well telescopes please sketch and show depths.

GROUND LEVEL

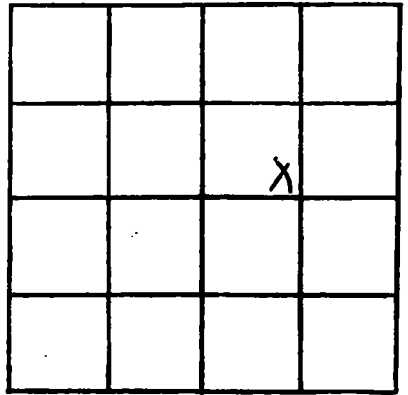

SECTION 27

Please indicate well location X.

ADDITIONAL INFORMATION

If more than one screen,
show locations of each on sketch.