

MISSISSIPPI DEPARTMENT OF NATURAL RESOURCES
Bureau of Land and Water Resources
 Southport Mall
 P.O. Box 10631
 Jackson, Mississippi 39209
WATER WELL DRILLERS LOG

Hancock
K 2532

6-26- 1984 Wood Well Reg. Hancock
 date well completed firm name county well located

LANDOWNER: Hayward Lambert
Hayward
Rt. 4, Box 380
Bay St. Louis, Mo.
 (mailing address)

WELL LOCATION:
 sec. 27 T-8 N R-13 E-14
4 miles N/W of B.S.L.
 (distance) (direction) (nearest town)

WELL PURPOSE: Home
 (home, irrigation, municipal, industrial)

WELL COMPLETION DATA:

(1) diameter (inches) 2"

(2) total depth (feet) 415

(3) static water level (feet) 1 below above
 top of ground

(4) casing PVC 405
 (material) (depth)

- If telescope see back.
 (size)

(5) screen 10' -
 (length) (depth to top)

2" PVC
 (size) (material)

(6) pump - -
 (HP) (yield gpm)

-
 (type power)

(7) electric log NO
 (yes or no)

N/A
 (organization running log)

(8) how well bottom plugged BWD

description of formations encountered	from to	
<u>clay</u>	<u>0</u>	<u>16</u>
<u>sd</u>	<u>16</u>	<u>47</u>
<u>clay</u>	<u>47</u>	<u>76</u>
<u>sd</u>	<u>76</u>	<u>85</u>
<u>clay</u>	<u>85</u>	<u>106</u>
<u>sd</u>	<u>106</u>	<u>118</u>
<u>clay-silt</u>	<u>118</u>	<u>152</u>
<u>sd</u>	<u>152</u>	<u>168</u>
<u>clay-silt</u>	<u>168</u>	<u>275</u>
<u>fine sd</u>	<u>275</u>	<u>310</u>
<u>clay-silt</u>	<u>310</u>	<u>386</u>
<u>sd</u>	<u>386</u>	<u>415</u>

DEPT. OF NATURAL RESOURCES
 BUREAU OF LAND & WATER RESOURCES


AUG 3 1984

RECEIVED

DRILLERS REMARKS: N/A

If well telescopes please sketch and show depths.

GROUND LEVEL

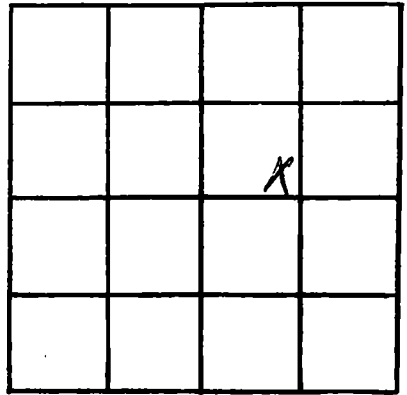

SECTION 27

Please indicate well location X.

ADDITIONAL INFORMATION

A series of horizontal lines for writing additional information, starting below the 'ADDITIONAL INFORMATION' header and extending to the bottom of the page.

If more than one screen, show locations of each on sketch.