

MISSISSIPPI DEPARTMENT OF NATURAL RESOURCES
Bureau of Land and Water Resources
 Southport Mall
 P.O. Box 10631
 Jackson, Mississippi 39209
WATER WELL DRILLERS LOG

Hancock
R 2533

7-3-84 19 McMie Well Works Hancock
 date well completed firm name county well located

LANDOWNER Richard Cooper
#6 Palmer Place
Musht. Mo.
 (mailing address)

description of formations encountered	from	to
	<u>sand</u>	<u>0</u>

WELL LOCATION:
 sec. 22 T. 8 N. R. 13 E. 14
2 miles W of D.C.
 (distance) (direction) (nearest town)

WELL PURPOSE:
 (home, irrigation, municipal, industrial)

- WELL COMPLETION DATA:
- (1) diameter (inches) 2"
 - (2) total depth (feet) 30'
 - (3) static water level (feet) _____ below
 top of ground. _____ above
 - (4) casing Pch 80, 20
 (material) (depth)
 _____ if telescope see back.
 (size)
 - (5) screen 10 _____ 20
 (length) (depth to top)
2", Pch 80 to slot
 (size) (material)
 - (6) pump 1/2 _____ 15
 (HP) (yield gpm)
elec
 (type power)
 - (7) electric log _____
 (year or no)

 (organization running log)
 - (8) how well bottom plugged Cap

DRILLERS REMARKS:


DEPT. OF NATURAL RESOURCES
 BUREAU OF LAND & WATER RESOURCES

AUG 13 1984

RECEIVED

If well telescopes please sketch and show depths.

GROUND LEVEL

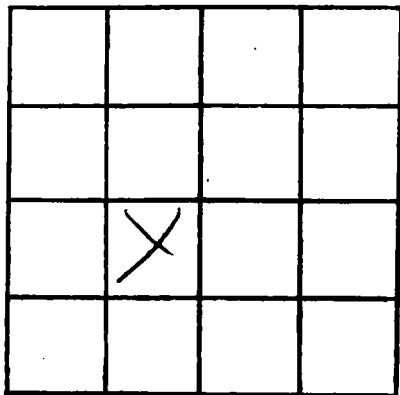

SECTION _____

Please indicate well location X.

ADDITIONAL INFORMATION

If more than one screen, show locations of each on sketch.