

MISSISSIPPI DEPARTMENT OF NATURAL RESOURCES

Bureau of Land and Water Resources

Southport Mall

P.O. Box 10631

Jackson, Mississippi 39209

WATER WELL DRILLERS LOG

Hancock  
K2534

7-17-84 19 McNeil Well Works Hancock  
date well completed firm name county well located

LANDOWNER: Mrs. Mitchell  
Wave land, Mo  
(mailing address)

| description of formations encountered | from       | to         |
|---------------------------------------|------------|------------|
| <u>mud</u>                            | <u>0</u>   | <u>20</u>  |
| <u>sand</u>                           | <u>20</u>  | <u>40</u>  |
| <u>mud</u>                            | <u>40</u>  | <u>460</u> |
| <u>mud &amp; sand</u>                 | <u>460</u> | <u>480</u> |
|                                       | <u>480</u> | <u>560</u> |

WELL LOCATION:  
sec. A T & N R 3 E  
3 miles W of BSL  
(distance) (direction) (nearest town)

WELL PURPOSE:  
(home, irrigation, municipal, industrial)

WELL COMPLETION DATA:

(1) diameter (inches) 2 1/2"

(2) total depth (feet) 560

(3) static water level (feet) 30 <sup>below</sup> <sub>above</sub> top of ground.

(4) casing sch 40 PVC, 350,  
(material) (depth)

(size) If telescope see back.

(5) screen 10', 350'  
(length) (depth to top)

2", sch 80 PVC  
(size) (material)

(6) pump 1 10  
(HP) (yield gpm)

elec  
(type power)

(7) electric log —  
(yes or no)

(organization running log) Real

(8) how well bottom plugged Real

DEPT. OF NATURAL RESOURCES  
BUREAU OF LAND & WATER RESOURCES


REC'D 10 10 84

RECEIVED

DRILLERS REMARKS:

If well telescopes please sketch and show depths.

GROUND LEVEL

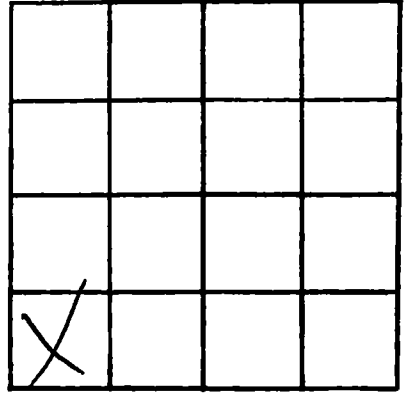

SECTION \_\_\_\_\_

Please indicate well location X.

ADDITIONAL INFORMATION

If more than one screen,  
show locations of each on sketch.