

MISSISSIPPI DEPARTMENT OF NATURAL RESOURCES

Bureau of Land and Water Resources

Southport Mall

P.O. Box 10631

Jackson, Mississippi 39209

WATER WELL DRILLERS LOG

Hancock
K2535

7-18-

19

84 Ward Well Drg.

Hancock

date well completed

firm name

county well located

LANDOWNER: Louis Ferrell

North Beach

Bay St. Louis, ms.
(mailing address)

WELL LOCATION:

sec 27 T-8 N R-13 E 14
2 miles N/E of BSL
(distance) (direction) (nearest town)

WELL PURPOSE: None
(home, irrigation, municipal, industrial)

WELL COMPLETION DATA:

- (1) diameter (inches) 2"
- (2) total depth (feet) 285
- (3) static water level (feet) 3 below above top of ground.
- (4) casing PVC, 275,
(material) (depth)
- if telescope see back.
(size)
- (5) screen 10', -
(length) (depth to top)
2", PVC
(size) (material)
- (6) pump -, -
(HP) (yield gpm)
(type power)
- (7) electric log NO
(yes or no)
N/A
(organization running log)
- (8) how well bottom plugged BWV

description of formations encountered

from to


| | | |
|--------------------|------------|------------|
| <u>Sely Soil -</u> | <u>0</u> | <u>3</u> |
| <u>clay</u> | <u>3</u> | <u>8</u> |
| <u>SS</u> | <u>8</u> | <u>34</u> |
| <u>clay - silt</u> | <u>34</u> | <u>96</u> |
| <u>sd</u> | <u>96</u> | <u>147</u> |
| <u>clay - silt</u> | <u>147</u> | <u>248</u> |
| <u>Coarse sd</u> | <u>148</u> | <u>285</u> |

DRILLERS REMARKS: N/A

DEPT. OF NATURAL RESOURCES
BUREAU OF LAND & WATER RESOURCES
SEP - 4 1984
RECEIVED

If well telescopes please sketch and show depths.

GROUND LEVEL

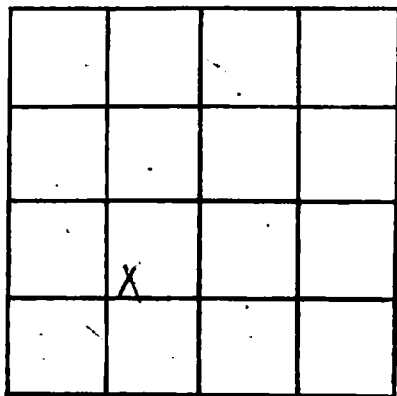

SECTION 37

Please indicate well location X.

ADDITIONAL INFORMATION

If more than one screen, show locations of each on sketch.

