

MISSISSIPPI DEPARTMENT OF NATURAL RESOURCES

Bureau of Land and Water Resources

Southport Mall

P.O. Box 10631

Jackson, Mississippi 39209

WATER WELL DRILLERS LOG

HANCOCK
K2536

8-8-1984 date well completed 84 Ward Well Drg. firm name Hancock county well located

LANDOWNER: John Escudé
Garden Drive
Bay St. Louis ms.
(mailing address)

WELL LOCATION:
sec. 27 T. 8 N. R. 13 E. 14
5 miles N/W of B.S.L.
(distance) (direction) (nearest town)

WELL PURPOSE: Camp
(home, irrigation, municipal, industrial)

- WELL COMPLETION DATA:
- (1) diameter (inches) 2"
 - (2) total depth (feet) 170
 - (3) static water level (feet) 6 ^{below} _{above} top of ground.
 - (4) casing PVC 160
(material) (depth)
____ (size) If telescope see back.
 - (5) screen 10' -
(length) (depth to top)
2" PVC
(size) (material)
 - (6) pump owner -
(HP) (yield gpm)
____ (type power)
 - (7) electric log NO
(yes or no)
N/A
(organization running log)
 - (8) how well bottom plugged BWV

description of formations encountered	from	to
<u>fill - clay</u>	<u>0</u>	<u>15</u>
<u>sd</u>	<u>15</u>	<u>46</u>
<u>clay - silt</u>	<u>46</u>	<u>74</u>
<u>sd</u>	<u>74</u>	<u>88</u>
<u>clay</u>	<u>88</u>	<u>105</u>
<u>fine sd</u>	<u>105</u>	<u>120</u>
<u>clay - silt</u>	<u>120</u>	<u>152</u>
<u>sd</u>	<u>152</u>	<u>170</u>


DEPT. OF NATURAL RESOURCES
BUREAU OF LAND & WATER RESOURCES

OCT 19 1984
RECEIVED

DRILLERS REMARKS: over

If well telescopes please sketch and show depths.

GROUND LEVEL

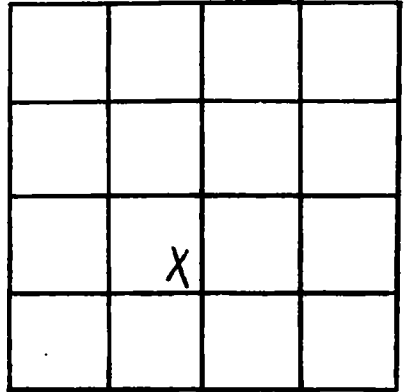

SECTION 27

Please indicate well location X.

ADDITIONAL INFORMATION

This well was a replacement for an old well. The old well had a bad casing & letting brackish water & salt in.

The new well was drilled approximately 15 feet from the old well but contained heavy iron & salt content.

The balance of info. per our conversation on Oct. 16, 1984.

If more than one screen, show locations of each on sketch.