

MISSISSIPPI DEPARTMENT OF NATURAL RESOURCES

Bureau of Land and Water Resources

Southport Mall

P.O. Box 10631

Jackson, Mississippi 39209

WATER WELL DRILLERS LOG

Hancock  
K2538

Aug. 11 1984 Ward Well Dlg. Hancock  
date well completed firm name county well located

LANDOWNER: Milton Bernard  
3rd St.  
Bay St. Louis, ms.  
(mailing address)

WELL LOCATION:  
sec. 29 T 8 N R 13 E  
8 miles N/W of Waveland  
(distance) (direction) (nearest town)

WELL PURPOSE: Home  
(home, irrigation, municipal, industrial)

- WELL COMPLETION DATA:
- diameter (inches) 2"
  - total depth (feet) 115
  - static water level (feet) 6 below above  
top of ground.
  - casing PVC 105  
(material) (depth)  
- (size) if telescope see back.
  - screen 10' -  
(length) (depth to top)  
2" PVC  
(size) (material)
  - pump none -  
(HP) (yield gpm)  
- (type power)
  - electric log NO  
(yes or no)  
N/A (organization running log)
  - how well bottom plugged BWV


description of formations encountered	from	to
<u>fill - clay</u>	<u>0</u>	<u>6</u>
<u>sd</u>	<u>6</u>	<u>24</u>
<u>clay</u>	<u>24</u>	<u>36</u>
<u>sd</u>	<u>36</u>	<u>56</u>
<u>clay</u>	<u>56</u>	<u>94</u>
<u>coarse sd</u>	<u>94</u>	<u>115</u>

DRILLERS REMARKS: N/A

DEPT. OF NATURAL RESOURCES  
BUREAU OF LAND & WATER RESOURCES  
OCT 19 1984  
RECEIVED

If well telescopes please sketch and show depths.

GROUND LEVEL

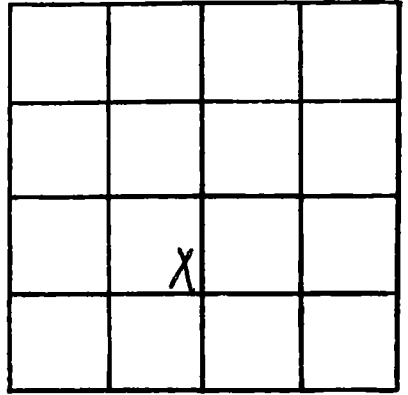

SECTION 29

Please indicate well location X.

**ADDITIONAL INFORMATION**

If more than one screen,  
show locations of each on sketch.