

MISSISSIPPI DEPARTMENT OF NATURAL RESOURCES

Bureau of Land and Water Resources

Southport Mall

P.O. Box 10631

Jackson, Mississippi 39209

WATER WELL DRILLERS LOG

Hancock
K 2539

8-13

1984 Ward Well Dlg

Hancock

date well completed

firm name

county well located

LANDOWNER: Dale Tambrella

description of formations encountered

from

to

P.O. Box 161

Clay

0

18

Bay St. Louis, ms.
(mailing address)

SC

18

42

Clay

42

105

SD

105

132

Clay - Silt

132

276

Red Gravel - SC

276

320

WELL LOCATION:

sec. 9 T. 8 N. R. 13 E.
5 miles S/W of Waveland
(distance) (direction) (nearest town)

WELL PURPOSE: Home
(home, irrigation, municipal, industrial)

WELL COMPLETION DATA:

- (1) diameter (inches) 2"
- (2) total depth (feet) 320
- (3) static water level (feet) 12 ^{below} top of ground.

- (4) casing PVC 310
(material) (depth)
- if telescope see back.
(size)

- (5) screen 10' -
(length) (depth to top)
2" PVC
(size) (material)

- (6) pump owner -
(HP) (yield gpm)
-
(type power)

- (7) electric log NO
(yes or no)
N/A
(organization running log)

- (8) how well bottom plugged 3WV

DRILLERS REMARKS: N/A


MISSISSIPPI DEPARTMENT OF NATURAL RESOURCES
BUREAU OF LAND AND WATER RESOURCES

OCT 10 1984

RECEIVED

If well telescopes please sketch and show depths.

GROUND LEVEL

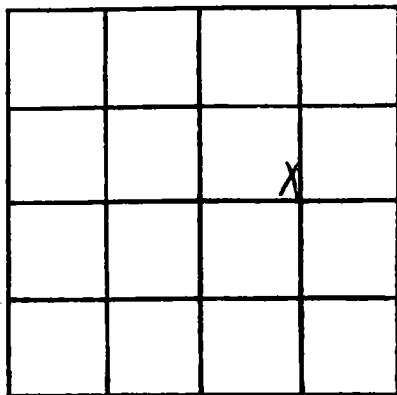

SECTION 9

Please indicate well location X.

ADDITIONAL INFORMATION

If more than one screen, show locations of each on sketch.