

MISSISSIPPI DEPARTMENT OF NATURAL RESOURCES

Bureau of Land and Water Resources

Southport Mall

P.O. Box 10631

Jackson, Mississippi 39209

WATER WELL DRILLERS LOG

HANCOK
K 2540

8-22

date well completed

1984 Ward Well Dly

firm name

Hancock

county well located

LANDOWNER: Mary Mouch

Rt. 1a Box 80

Bry' St. Louis, Jr.
(mailing address)

WELL LOCATION:

sec. 27 T. 8 N R. 13 E 14

5 miles N/W of Waveland
(distance) (direction) (nearest town)

WELL PURPOSE:

Home
(home, irrigation, municipal, industrial)

WELL COMPLETION DATA:

- (1) diameter (inches) 2"
- (2) total depth (feet) 185
- (3) static water level (feet) 5 ^{below} _{above} top of ground.
- (4) casing PVC, 125.
(material) (depth)

- (size) If telescope see back.

- (5) screen 10' (length) (depth to top)
2" (size) PVC (material)

- (6) pump 1/2 (HP) 10 (yield gpm)
Elec. (type power)

- (7) electric log no (yes or no)
N/A (organization running log)

- (8) how well bottom plugged GWV

DRILLERS REMARKS: N/A

description of formations encountered

from to


<u>Shell-clay-fill</u>	<u>0</u>	<u>2</u>
<u>clay</u>	<u>2</u>	<u>18</u>
<u>clay-silt</u>	<u>18</u>	<u>47</u>
<u>clay-silt</u>	<u>47</u>	<u>104</u>
<u>clay-silt</u>	<u>104</u>	<u>115</u>
<u>clay-silt</u>	<u>115</u>	<u>160</u>
<u>clay-silt</u>	<u>160</u>	<u>185</u>

DEPT. OF NATURAL RESOURCES
BUREAU OF LAND & WATER RESOURCES

OCT 19 1984
RECEIVED

If well telescopes please sketch and show depths.

GROUND LEVEL

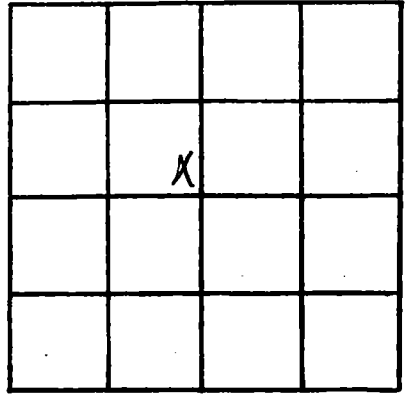

SECTION 27

Please indicate well location X.

ADDITIONAL INFORMATION

If more than one screen,
show locations of each on sketch.