

MISSISSIPPI DEPARTMENT OF NATURAL RESOURCES

Bureau of Land and Water Resources

Southport Mall

P.O. Box 10631

Jackson, Mississippi 39209

WATER WELL DRILLERS LOG

Hancock
K 2534

8-24 1984 Wood Well Dlg. Hancock
date well completed firm name county well located

LANDOWNER: Al Clark
Hancock Drive
Bay St. Louis, ms.
(mailing address)

| description of formations encountered | from | to |
|---------------------------------------|------------|------------|
| <u>fill - clay</u> | <u>0</u> | <u>15</u> |
| <u>sd</u> | <u>15</u> | <u>44</u> |
| <u>clay</u> | <u>44</u> | <u>165</u> |
| <u>sd</u> | <u>165</u> | <u>128</u> |
| <u>clay</u> | <u>128</u> | <u>147</u> |
| <u>Red Shovel - sd</u> | <u>147</u> | <u>165</u> |

WELL LOCATION:
sec. 6 T. 9 N. R. 14 E.
9 miles W of Waveland
(distance) (direction) (nearest town)

WELL PURPOSE: Home
(home, irrigation, municipal, industrial)

- WELL COMPLETION DATA:
- (1) diameter (inches) 2"
 - (2) total depth (feet) 165
 - (3) static water level (feet) 12 ^{below} _{above} top of ground.
 - (4) casing PVC, 155,
(material) (depth)
 - if telescope see back.
(size)
 - (5) screen 10', -
(length) (depth to top)
 - 2", PVC
(size) (material)
 - (6) pump owner, -
(HP) (yield gpm)
 - (type power)
 - (7) electric log NO
(yes or no)
 - N/A
(organization running log)
 - (8) how well bottom plugged BWU


DRILLERS REMARKS: N/A

DEPT. OF NATURAL RESOURCES
BUREAU OF LAND & WATER RESOURCES

OCT 19 1984
RECEIVED

If well telescopes please sketch and show depths.

GROUND LEVEL

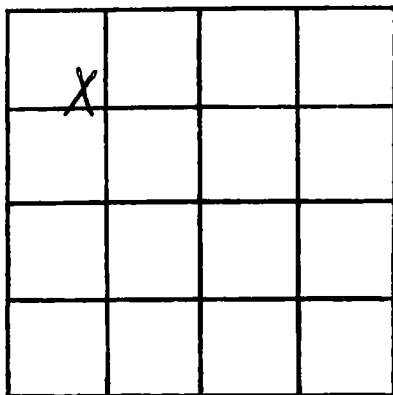

SECTION 6

Please indicate well location X.

ADDITIONAL INFORMATION

If more than one screen, show locations of each on sketch.