

MISSISSIPPI DEPARTMENT OF NATURAL RESOURCES

Bureau of Land and Water Resources

Southport Mall

P.O. Box 10631

Jackson, Mississippi 39209

WATER WELL DRILLERS LOG

HANCOCK  
K 2542

8-27 1984 Ward Well Drg Hancock  
date well completed firm name county well located

LANDOWNER Warren Taylor  
Bayou View Drive  
Bay St. Louis, ms.  
(mailing address)

description of formations encountered	from	to
	<u>fill - clay</u>	<u>0</u>
<u>sd</u>	<u>18</u>	<u>36</u>
<u>clay - silt</u>	<u>36</u>	<u>95</u>
<u>sd</u>	<u>95</u>	<u>122</u>
<u>clay - silt</u>	<u>122</u>	<u>155</u>
<u>sd</u>	<u>155</u>	<u>174</u>

WELL LOCATION:  
sec. 27 T. 8 N R. 13 E  
7 miles N/W of Waveland  
(distance) (direction) (nearest town)

WELL PURPOSE: Home  
(home, irrigation, municipal, industrial)

- WELL COMPLETION DATA:
- (1) diameter (inches) 2"
  - (2) total depth (feet) 174
  - (3) static water level (feet) 5 below above top of ground.
  - (4) casing PVC, 164,  
(material) (depth)  
- (size) If telescope see back.
  - (5) screen 10', -  
(length) (depth to top)  
2", PVC  
(size) (material)
  - (6) pump owner -  
(HP) (yield gpm)  
- (type power)
  - (7) electric log NO  
(yes or no)  
N/A  
(organization running log)
  - (8) how well bottom plugged OWU


DRILLERS REMARKS: N/A

DEPT. OF NATURAL RESOURCES  
BUREAU OF LAND & WATER RESOURCES

OCT 19 1984  
RECEIVED

If well telescopes please sketch and show depths.

GROUND LEVEL

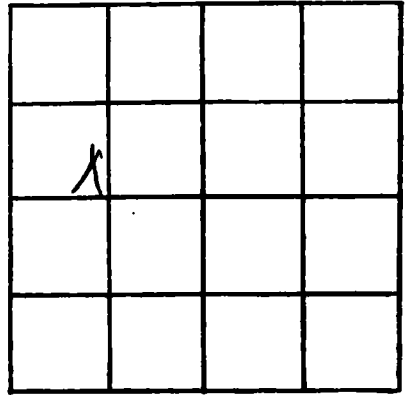

SECTION 27

Please indicate well location X.

ADDITIONAL INFORMATION

If more than one screen,  
show locations of each on sketch.