

MISSISSIPPI DEPARTMENT OF NATURAL RESOURCES
Bureau of Land and Water Resources
 Southport Mall
 P.O. Box 10631
 Jackson, Mississippi 39209
WATER WELL DRILLERS LOG

Hancock
K2544

Sept. 11 1984 Ward Well Dlg Hancock
 date well completed firm name county well located

LANDOWNER: Robert Estrada Sr.
401 West Adam St.
Bay St. Louis, ms.
 (mailing address)

description of formations encountered	from	to
	<u>fill - clay</u>	<u>0</u>
<u>sd</u>	<u>15</u>	<u>38</u>
<u>clay</u>	<u>38</u>	<u>96</u>
<u>sd</u>	<u>96</u>	<u>131</u>
<u>clay - silt</u>	<u>131</u>	<u>152</u>
<u>Perm. Shale - sd</u>	<u>152</u>	<u>167</u>

WELL LOCATION:
 sec. 6 T. 9 N R. 14 E
6 miles W of Wardland
 (distance) (direction) (nearest town)

WELL PURPOSE: None
 (home, irrigation, municipal, industrial)

- WELL COMPLETION DATA:**
- diameter (inches) 2"
 - total depth (feet) 167
 - static water level (feet) 12 below above top of ground.
 - casing PVC 157
 (material) (depth)
— if telescope see back.
 (size)
 - screen 10' —
 (length) (depth to top)
2" PVC
 (size) (material)
 - pump — —
 (HP) (yield gpm)
 (type power)
 - electric log NO
 (yes or no)
N/A
 (organization running log)
 - how well bottom plugged BW

DRILLERS REMARKS: N/A


DEPT. OF NATURAL RESOURCES
 BUREAU OF LAND & WATER RESOURCES

DEC - 3 1984

RECEIVED

If well telescopes please sketch and show depths.

GROUND LEVEL

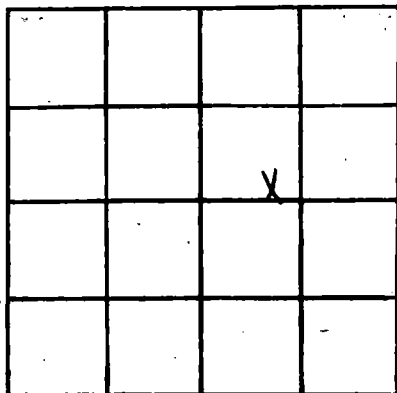

SECTION 6

Please indicate well location X.

ADDITIONAL INFORMATION

If more than one screen, show locations of each on sketch.