

MISSISSIPPI DEPARTMENT OF NATURAL RESOURCES
Bureau of Land and Water Resources
 Southport Mall
 P.O. Box 10631
 Jackson, Mississippi 39209
WATER WELL DRILLERS LOG

Hancock
K 25.45

Sept. 12 1984 Wood Well Dlg. Hancock
 date well completed firm name county well located

LANDOWNER: Hank Brown
Covington, St.
Bay St. Louis, ms.
 (mailing address)

description of formations encountered	from	to
	<u>top soil - clay</u>	<u>0</u>
<u>clay</u>	<u>12</u>	<u>42</u>
<u>clay</u>	<u>42</u>	<u>105</u>
<u>clay - silt</u>	<u>105</u>	<u>132</u>
<u>Red Shovel - sd</u>	<u>132</u>	<u>154</u>
	<u>154</u>	<u>167</u>

WELL LOCATION:
 sec. 6 T-9 N R-14 E
6 miles W of Waveland
 (distance) (direction) (nearest town)

WELL PURPOSE: Home
 (home, irrigation, municipal, industrial)

- WELL COMPLETION DATA:
- (1) diameter (inches) 2"
 - (2) total depth (feet) 167
 - (3) static water level (feet) 12 ^{below} _{above} top of ground.
 - (4) casing PVC / 157
 (material) (depth)
 (size) if telescope see back.
 - (5) screen 10' / -
 (length) (depth to top)
2" / PVC
 (size) (material)
 - (6) pump - / -
 (HP) (yield gpm)
 (type power)
 - (7) electric log NO
 (yes or no)
N/A
 (organization running log)
 - (8) how well bottom plugged BWU

DRILLERS REMARKS: N/A


DEPT. OF NATURAL RESOURCES
 BUREAU OF LAND & WATER RESOURCES

DEC - 8 1984

RECEIVED

If well telescopes please sketch and show depths.

GROUND LEVEL

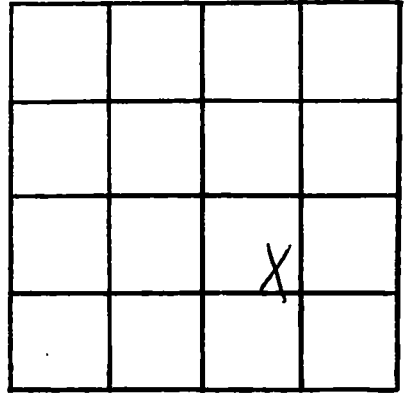

SECTION 6

Please indicate well location X.

ADDITIONAL INFORMATION

A series of horizontal lines for writing additional information, starting below the 'ADDITIONAL INFORMATION' header and extending to the bottom of the page.

If more than one screen, show locations of each on sketch.