

MISSISSIPPI DEPARTMENT OF NATURAL RESOURCES
 Bureau of Land and Water Resources
 Southport Mall
 P.O. Box 10631
 Jackson, Mississippi 39209
WATER WELL DRILLERS LOG

Hancock
K 2546

Sept. 17 1984 Ward Well Dlg. Hancock
 date well completed firm name county well located

LANDOWNER: George Parr
Rt. 7, Box 270
Bay St. Louis, Miss
 (mailing address)

WELL LOCATION:
 sec. 6 T 9 N R 14 E
6 1/2 miles W of B.S.L.
 (distance) (direction) (nearest town)

description of formations encountered	from	to
<u>fill - clay</u>	<u>0</u>	<u>15</u>
<u>Sl</u>	<u>15</u>	<u>36</u>
<u>Clay</u>	<u>30</u>	<u>96</u>
<u>Sl</u>	<u>96</u>	<u>128</u>
<u>Clay - silt</u>	<u>128</u>	<u>145</u>
<u>Pla Shovel - sd</u>	<u>145</u>	<u>160</u>

WELL PURPOSE: Home
 (home, irrigation, municipal, industrial)

WELL COMPLETION DATA:

(1) diameter (inches) 2"

(2) total depth (feet) 160

(3) static water level (feet) 12 below above top of ground.

(4) casing PVC, 150,
 (material) (depth)
 If telescope see back.
 (size)

(5) screen 10',
 (length) (depth to top)
2", PVC
 (size) (material)

(6) pump ,
 (HP) (yield gpm)

 (type power)

(7) electric log NO
 (yes or no)
N/A
 (organization running log)

(8) how well bottom plugged BWV

DEPT. OF NATURAL RESOURCES
 BUREAU OF LAND & WATER RESOURCES


DEC - 3 1984

DRILLERS REMARKS: N/A

RECEIVED

If well telescopes please sketch and show depths.

GROUND LEVEL

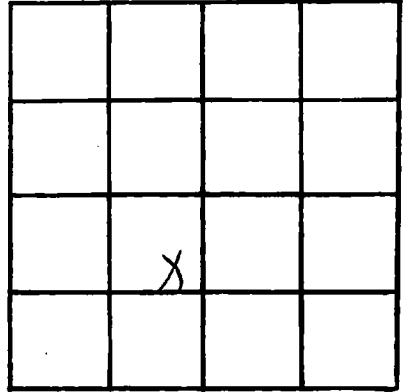

SECTION 6

Please indicate well location X.

ADDITIONAL INFORMATION

If more than one screen,
show locations of each on sketch.