

**MISSISSIPPI DEPARTMENT OF NATURAL RESOURCES**  
**Bureau of Land and Water Resources**  
 Southport Mall  
 P.O. Box 10631  
 Jackson, Mississippi 39209  
**WATER WELL DRILLERS LOG**

Hancock  
K2548

Sept. 26 - 19 84 Ward Well Co Hancock  
 date well completed firm name county well located

LANDOWNER: Harlan Hanson  
P.O. Box 672  
Bay St. Louis, ms  
 (mailing address)  
 WELL LOCATION:  
 sec 37 T 8 N R 13 E 14  
4 miles N/W of B.S.L.  
 (distance) (direction) (nearest town)

description of formations encountered	from	to
	<u>fill - clay</u>	<u>0</u>
<u>sd</u>	<u>14</u>	<u>46</u>
<u>clay</u>	<u>46</u>	<u>94</u>
<u>sd</u>	<u>94</u>	<u>168</u>
<u>clay - silt</u>	<u>168</u>	<u>505</u>
<u>chase sd</u>	<u>505</u>	<u>550</u>

WELL PURPOSE: Home  
 (home, irrigation, municipal, industrial)

WELL COMPLETION DATA:  
 (1) diameter (inches) 2"  
 (2) total depth (feet) 550  
 (3) static water level (feet) 5 below above  
 top of ground.  
 (4) casing PVC, 530,  
 (material) (depth)  
 (size) If telescope see back.  
 (5) screen 20', -  
 (length) (depth to top)  
2", PVC  
 (size) (material)  
 (6) pump -, -  
 (HP) (yield gpm)  
 (type power)  
 (7) electric log NO  
 (yes or no)  
N/A  
 (organization running log)  
 (8) how well bottom plugged SWD

DRILLERS REMARKS: N/A


DEPT. OF NATURAL RESOURCES  
 BUREAU OF LAND & WATER RESOURCES

DEC - 9 1984

**RECEIVED**

If well telescopes please sketch and show depths.

GROUND LEVEL

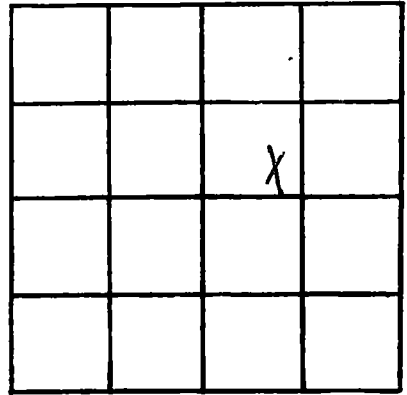

SECTION 37

Please indicate well location X.

ADDITIONAL INFORMATION

If more than one screen,  
show locations of each on sketch.