

MISSISSIPPI DEPARTMENT OF NATURAL RESOURCES
 Bureau of Land and Water Resources
 Southport Mall
 P.O. Box 10631

Jackson, Mississippi 39209
WATER WELL DRILLERS LOG

Sept. 26 1984 Wood Well Drg. Hancock
 date well completed firm name county well located

LANDOWNER: Judy Gunn
Riverside Ave
Bay St. Louis m.
 (mailing address)

WELL LOCATION:
 sec. 29 T-8 N R-13 E
5 miles N/W of Warland
 (distance) (direction) (nearest town)

WELL PURPOSE: None
 (home, irrigation, municipal, industrial)

WELL COMPLETION DATA:

(1) diameter (inches) 2"

(2) total depth (feet) 345

(3) static water level (feet) 1 below above
 top of ground.

(4) casing PVC 335
 (material) (depth)

-
 (size) if telescope see back.

(5) screen 10' -
 (length) (depth to top)

2" PVC
 (size) (material)

(6) pump - -
 (HP) (yield gpm)

2
 (type power)

(7) electric log NO
 (yes or no)

N/A
 (organization running log)

(8) how well bottom plugged 3W

description of formations encountered	from	to
<u>FW-clay</u>	<u>0</u>	<u>17</u>
<u>sd</u>	<u>17</u>	<u>45</u>
<u>Clay</u>	<u>45</u>	<u>104</u>
<u>fine sd</u>	<u>104</u>	<u>115</u>
<u>clay-silt</u>	<u>115</u>	<u>176</u>
<u>fine sd</u>	<u>126</u>	<u>194</u>
<u>clay-silt</u>	<u>194</u>	<u>318</u>
<u>Coarse sd</u>	<u>318</u>	<u>345</u>

DEPT. OF NATURAL RESOURCES
 BUREAU OF LAND & WATER RESOURCES


DEC - 3 1984

RECEIVED

DRILLERS REMARKS: N/A

If well telescopes please sketch and show depths.

GROUND LEVEL

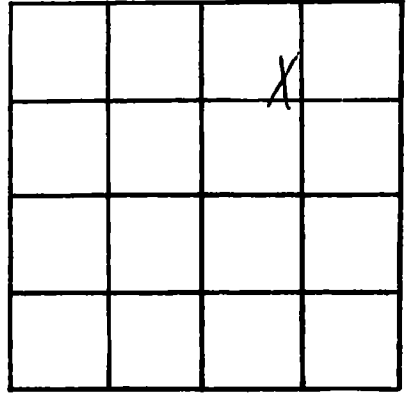

SECTION 29

Please indicate well location X.

ADDITIONAL INFORMATION

If more than one screen, show locations of each on sketch.