

MISSISSIPPI DEPARTMENT OF NATURAL RESOURCES

Bureau of Land and Water Resources

Southport Mall

P.O. Box 10631

Jackson, Mississippi 39209

WATER WELL DRILLERS LOG

Hancock
K2551

10-2
 date well completed

1984 Ward Well Drg.
 firm name

Hancock
 county well located

LANDOWNER: *John Mailhe*
Edna St.
Waveland, ms.
 (mailing address)

description of formations encountered	from	to
<i>Silt - clay</i>	<i>0</i>	<i>12</i>
<i>SD</i>	<i>12</i>	<i>44</i>
<i>clay</i>	<i>44</i>	<i>52</i>
<i>Clay wh shell</i>	<i>52</i>	<i>66</i>
<i>clay</i>	<i>66</i>	<i>97</i>
<i>SD</i>	<i>97</i>	<i>118</i>
<i>Clay - Silt</i>	<i>118</i>	<i>167</i>
<i>Red Shell - SD</i>	<i>167</i>	<i>190</i>

WELL LOCATION:
 sec. *3* T. *8* N R. *17* E *14*
1/4 miles *N/E* of *Waveland*
 (distance) (direction) (nearest town)

WELL PURPOSE: *Home*
 (home, irrigation, municipal, industrial)

WELL COMPLETION DATA:

(1) diameter (inches) *4" x 2"*

(2) total depth (feet) *190*

(3) static water level (feet) *15* ^{below} _{above} top of ground.

(4) casing *PVC* *170*
 (material) (depth)
 (size) if telescope see back.

(5) screen *20'* *-*
 (length) (depth to top)
2" *PVC*
 (size) (material)

(6) pump *owner* *-*
 (HP) (yield gpm)
 (type power)

(7) electric log *N/A*
 (yes or no)
N/A
 (organization running log)


(8) how well bottom plugged *BWV*

DRILLERS REMARKS: *N/A*

1-7-85
J.W.

If well telescopes please sketch and show depths.

GROUND LEVEL

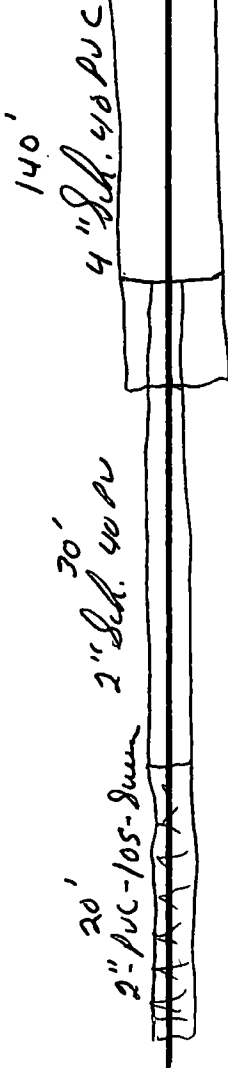

			X

SECTION 3

Please indicate well location X.

ADDITIONAL INFORMATION

If more than one screen, show locations of each on sketch.