

MISSISSIPPI DEPARTMENT OF NATURAL RESOURCES

Bureau of Land and Water Resources

Southport Mall

P.O. Box 10631

Jackson, Mississippi 39209

WATER WELL DRILLERS LOG

Hancock  
K 2552

10-7-84 19 McMinn Well Works Hancock  
 date well completed firm name county well located

LANDOWNER: Larry Matthews

650 Koko Ct.

Bay St. Louis, Ms.  
 (mailing address)

WELL LOCATION:

sec 19 T 8 N R 13 E  
2 miles NW of BSL  
 (distance) (direction) (nearest town)

WELL PURPOSE: Home  
 (home, irrigation, municipal, industrial)

WELL COMPLETION DATA:

- (1) diameter (inches) 2"
- (2) total depth (feet) 270'
- (3) static water level (feet) 30' <sup>below</sup> top of ground.
- (4) casing sch 40, 270'  
 (material) (depth)
- \_\_\_\_\_ If telescope see back.  
 (size)
- (5) screen 10, 270'  
 (length) (depth to top)
- 10', sch 40 6 slot  
 (size) (material)
- (6) pump 1, 10  
 (HP) (yield gpm)
- elec.  
 (type power)
- (7) electric log \_\_\_\_\_  
 (yes or no)
- \_\_\_\_\_ (organization running log)
- (8) how well bottom plugged Seal

description of formations encountered

from to

<u>m' &amp; s'</u>	<u>0</u>	<u>20</u>
<u>unconsol</u>	<u>20</u>	<u>100</u>
<u>m' &amp; s'</u>	<u>100</u>	<u>140</u>
<u>unconsol</u>	<u>140</u>	<u>180</u>
<u>m' &amp; s'</u>	<u>180</u>	<u>200</u>
<u>unconsol</u>	<u>200</u>	<u>220</u>
<u>m' &amp; s'</u>	<u>220</u>	<u>240</u>
<u>Sand</u>	<u>240</u>	<u>280</u>

DEPT. OF NATURAL RESOURCES  
 BUREAU OF LAND & WATER RESOURCES


DEC - 3 1984

RECEIVED

DRILLERS REMARKS:

If well telescopes please sketch and show depths.

GROUND LEVEL

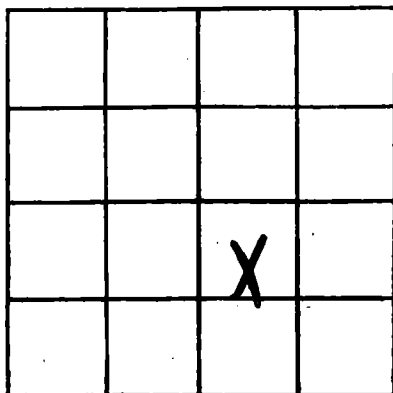

SECTION \_\_\_\_\_

Please indicate well location X.

ADDITIONAL INFORMATION

If more than one screen,  
show locations of each on sketch.