

MISSISSIPPI DEPARTMENT OF NATURAL RESOURCES

Bureau of Land and Water Resources

Southport Mall

P.O. Box 10631

Jackson, Mississippi 39209

WATER WELL DRILLERS LOG

Hancock
K 2554

10-23-1984
 date well completed

Ward Well Drg
 firm name

Hancock
 county well located

LANDOWNER: Francis Blyport
Railroad Ave. & Lenizetta
Clement Harbor, ms.
 (mailing address)

description of formations encountered	from	to
	Clay	0
sd	12	35
Clay	35	96
sd	96	112
Clay - silt	112	265
Coar sd	265	294

WELL LOCATION:
 sec. 17 T. 9 N. R. 14 E
 (distance) miles (direction) of Clement Harbor (nearest town)

WELL PURPOSE: Home
 (home, irrigation, municipal, industrial)

- WELL COMPLETION DATA:
- (1) diameter (inches) 2"
 - (2) total depth (feet) 294
 - (3) static water level (feet) 9 ^{below} _{above} top of ground.
 - (4) casing PVC 284
 (material) (depth)
 (size) if telescope see back.
 - (5) screen 10' -
 (length) (depth to top)
2" PVC
 (size) (material)
 - (6) pump owner -
 (HP) (yield gpm)
 (type power)
 - (7) electric log NO
 (yes or no)
N/A
 (organization running log)
 - (8) how well bottom plugged BWV


DRILLERS REMARKS: N/A

1-7-85
 JFW

If well telescopes please sketch and show depths.

0

GROUND LEVEL

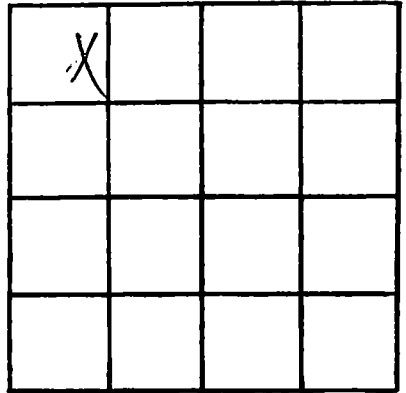

SECTION 17

Please indicate well location X.

ADDITIONAL INFORMATION

If more than one screen, show locations of each on sketch.