

MISSISSIPPI DEPARTMENT OF NATURAL RESOURCES

Bureau of Land and Water Resources

Southport Mall

P.O. Box 10631

Jackson, Mississippi 39209

WATER WELL DRILLERS LOG

Harvard
K2535


10-24-1984 Ward Well Dr. Harvard
date well completed firm name county well located

LANDOWNER: <u>Melvin Gray</u> <u>P.O. Box 85</u> <u>Lakeside Mrs.</u> (mailing address)	description of formations encountered <u>fill-clay</u> <u>sd</u> <u>clay</u> <u>sd</u> <u>clay-silt</u> <u>coal sd</u>	from	to
		0	12
		12	47
		47	95
		95	116
		116	165
		16	190
<p>WELL LOCATION: sec. <u>13</u> T <u>9</u> N R <u>14</u> E <u>8</u> miles <u>S/W</u> of <u>Ward</u> (distance) (direction) (nearest town)</p>			
<p>WELL PURPOSE: <u>Home</u> (home, irrigation, municipal, industrial)</p>			
<p>WELL COMPLETION DATA:</p>			
<p>(1) diameter (inches) <u>2"</u></p>			
<p>(2) total depth (feet) <u>195</u></p>			
<p>(3) static water level (feet) <u>10</u> <u>below</u> above top of ground.</p>			
<p>(4) casing <u>PVC</u>, <u>185</u>, (material) (depth)</p> <p><u>-</u> if telescope see back. (size)</p>			
<p>(5) screen <u>10'</u>, <u>-</u> (length) (depth to top)</p> <p><u>2"</u>, <u>PVC</u> (size) (material)</p>			
<p>(6) pump <u>Ormer</u>, <u>-</u> (HP) (yield gpm)</p> <p><u>-</u> (type power)</p>			
<p>(7) electric log <u>NO</u> (yes or no)</p> <p><u>N/A</u> (organization running log)</p>			
<p>(8) how well bottom plugged <u>BWU</u></p>			
<p>DRILLERS REMARKS: <u>N/A</u></p>			

1-7-85
JW

If well telescopes please sketch and show depths.

GROUND LEVEL

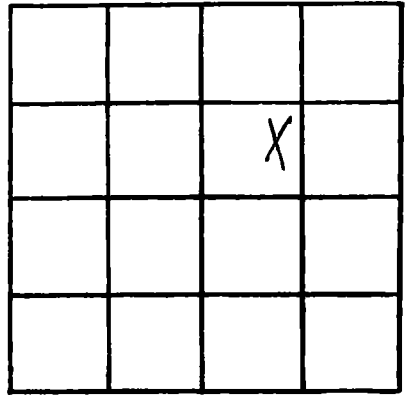

SECTION 8

Please indicate well location X.

ADDITIONAL INFORMATION

If more than one screen, show locations of each on sketch.