

MISSISSIPPI DEPARTMENT OF NATURAL RESOURCES

Bureau of Land and Water Resources

Southport Mall

P.O. Box 10631

Jackson, Mississippi 39209

WATER WELL DRILLERS LOG

Hancock  
K 2556

10-26-84

McNee Well Works

Hancock

date well completed

firm name

county well located

LANDOWNER W.H. Stephenson

description of formations encountered

from

to

Bay St. Louis, Ms.  
(mailing address)

<u>Sand</u>	<u>0</u>	<u>40</u>
<u>m' &amp; s'</u>	<u>40</u>	<u>50</u>
<u>mud</u>	<u>50</u>	<u>100</u>
<u>m' &amp; s'</u>	<u>100</u>	<u>120</u>
<u>mud</u>	<u>120</u>	<u>140</u>
<u>m' &amp; s'</u>	<u>140</u>	<u>160</u>
<u>Sand</u>	<u>160</u>	<u>200</u>

WELL LOCATION:

sec 17 T 8 N R 13 E / 14 S W  
2 miles NW of BSL  
(distance) (direction) (nearest town)

WELL PURPOSE:

(home, irrigation, municipal, industrial)

WELL COMPLETION DATA:

- (1) diameter (inches) 2"
- (2) total depth (feet) 200'
- (3) static water level (feet) 25 <sup>below</sup> top of ground.
- (4) casing 2 1/2" 190'  
(material) (depth)
- (size) if telescope see back.
- (5) screen 10' 190'  
(length) (depth to top)
- 2" Dch 60 63 lot  
(size) (material)
- (6) pump 1 8  
(HP) (yield gpm)
- elec  
(type power)
- (7) electric log             
(yes or no)
- (organization running log)
- (8) how well bottom plugged See

DRILLERS REMARKS:


DEPT. OF NATURAL RESOURCES  
BUREAU OF LAND & WATER RESOURCES

DEC - 3 1984

RECEIVED

If well telescopes please sketch and show depths.

GROUND LEVEL

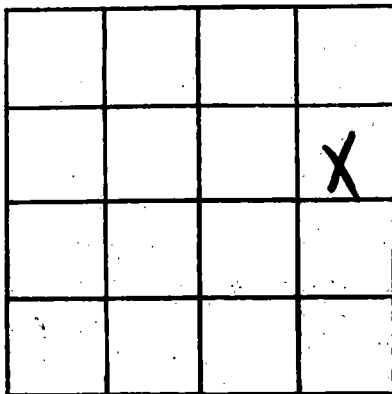

SECTION \_\_\_\_\_

Please indicate well location X.

ADDITIONAL INFORMATION

If more than one screen, show locations of each on sketch.