

MISSISSIPPI DEPARTMENT OF NATURAL RESOURCES
Bureau of Land and Water Resources
 Southport Mall
 P.O. Box 10631
 Jackson, Mississippi 39209
WATER WELL DRILLERS LOG

Hancock
K 2557

11-1-
 date well completed

1984 Woodwell Alg.
 firm name

Hancock
 county well located

LANDOWNER: John Bollar
Ramonda St.
Bay St. Louis, ms.
 (mailing address)

description of formations encountered	from	to
<u>Clay</u>	<u>0</u>	<u>18</u>
<u>SD</u>	<u>18</u>	<u>95</u>
<u>Clay</u>	<u>95</u>	<u>106</u>
<u>SD</u>	<u>106</u>	<u>125</u>
<u>Red Shovel - Case SD</u>	<u>125</u>	<u>147</u>

WELL LOCATION:
 sec. 43 T. 8 N R. 14 E
14 miles SE of B.S.L.
 (distance) (direction) (nearest town)

WELL PURPOSE: Heat Pump
 (home, irrigation, municipal, industrial)

- WELL COMPLETION DATA:
- diameter (inches) 4" x 2"
 - total depth (feet) 147'
 - static water level (feet) 15 ^{below} / _{above} top of ground.
 - casing PVC 120'
 (material) (depth)
 (size) if telescope see back.
 - screen 20' 127
 (length) (depth to top)
2" PVC
 (size) (material)
 - pump 1/2 sub. 20
 (HP) (yield gpm)
Elec.
 (type power)
 - electric log NO
 (yes or no)
N/A
 (organization running log)
 - how well bottom plugged BWU


DRILLERS REMARKS: Supply inspection well for water source heat pumps. - @

1-22-85
Jaw

If well telescopes please sketch and show depths.

Figure X paper

GROUND LEVEL

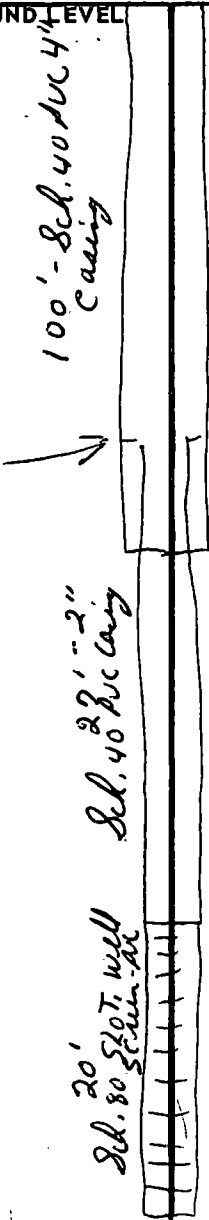

	X		

SECTION 43

Please indicate well location X.

ADDITIONAL INFORMATION

Two Well were drilled to the same depth. They were drilled about 100 feet apart. - one well was for supply - the other for injection.

If more than one screen, show locations of each on sketch.