

**MISSISSIPPI DEPARTMENT OF NATURAL RESOURCES**  
**Bureau of Land and Water Resources**  
 Southport Mall  
 P.O. Box 10631  
 Jackson, Mississippi 39209  
**WATER WELL DRILLERS LOG**

Hancock  
R. 2559

11-6- 1984 Ward Well Pkg. Hancock  
 date well completed firm name county well located

LANDOWNER: R. J. Canene  
621 N. Beach Blvd  
Warland, ms.  
 (mailing address)

WELL LOCATION:  
 sec. 3 T. 29 N. R. 13 E.  
1 1/2 miles SE in Warland  
 (distance) (direction) (nearest town)

description of formations encountered	from	to
	<u>Clay</u>	<u>0</u>
<u>Sd</u>	<u>15</u>	<u>53</u>
<u>Clay</u>	<u>53</u>	<u>86</u>
<u>Sdy-clay-Silt</u>	<u>86</u>	<u>125</u>
<u>fine Sd</u>	<u>125</u>	<u>148</u>
<u>Rm Shale-Sd</u>	<u>148</u>	<u>155</u>
<u>Clay-Silt</u>	<u>155</u>	<u>480</u>
<u>Med. coarse Sd</u>	<u>480</u>	<u>525</u>

WELL PURPOSE: irrigation  
 (home, irrigation, municipal, industrial)

WELL COMPLETION DATA:

(1) diameter (inches) 4" x 2"

(2) total depth (feet) 525

(3) static water level (feet) 6 below above top of ground.

(4) casing PVC, 505,  
 (material) (depth)  
 (size) if telescope see back.

(5) screen 20', 505  
 (length) (depth to top)  
2", PVC  
 (size) (material)

(6) pump crane, -  
 (HP) (yield gpm)  
 (type power)

(7) electric log NO  
 (yes or no)  
N/A  
 (organization running log)



(8) how well bottom plugged BWD

DRILLERS REMARKS: N/A

1-22-85  
240

If well telescopes please sketch and show depths.

GROUND LEVEL

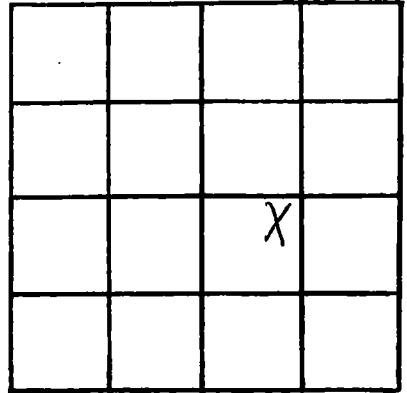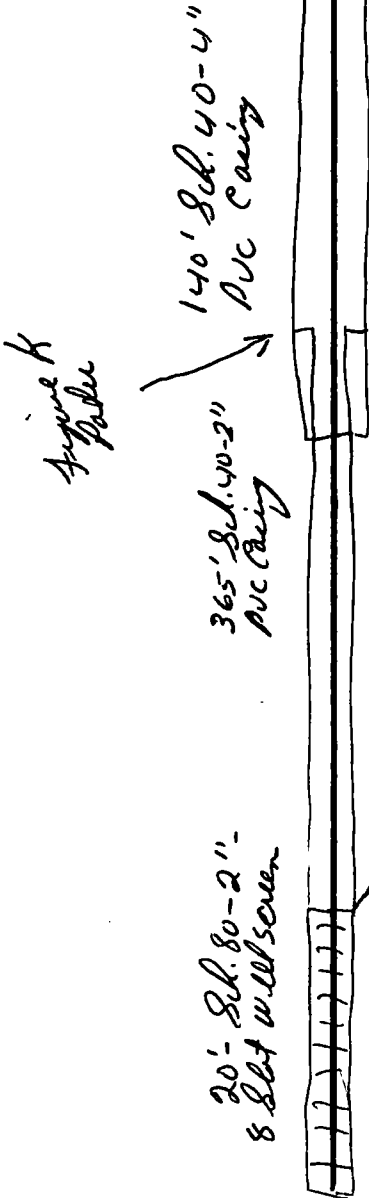

SECTION 3

Please indicate well location X.

ADDITIONAL INFORMATION

*To be used for irrigation*

If more than one screen, show locations of each on sketch.