

MISSISSIPPI DEPARTMENT OF NATURAL RESOURCES

Bureau of Land and Water Resources

Southport Mall

P.O. Box 10631

Jackson, Mississippi 39209

WATER WELL DRILLERS LOG

Hancock  
K 2560

11-7- 1984  
 date well completed

84 Ward Well Dr.  
 firm name

Hancock  
 county well located

LANDOWNER Camille Turner  
Rt. 2, Lower Bay Rd.  
Bay St. Louis, ms.  
 (mailing address)

description of formations encountered

from	to
0	18
18	47
47	95
95	115
115	160
160	185

Clay  
sd  
Clay  
sd  
Clay - Silt  
Coars sd

WELL LOCATION:

sec. 7 T. 9 N. R. 14 E.  
5 miles SW of Harland  
 (distance) (direction) (nearest town)

WELL PURPOSE:

(home, irrigation, municipal, industrial)

WELL COMPLETION DATA:


- (1) diameter (inches) 2"
- (2) total depth (feet) 185
- (3) static water level (feet) 12 <sup>below</sup>/<sub>above</sub> top of ground.
- (4) casing PVC 175  
 (material) (depth)  
 (size) If telescope see back.
- (5) screen 10' -  
 (length) (depth to top)  
2" PVC  
 (size) (material)
- (6) pump owner -  
 (HP) (yield gpm)  
 (type power)
- (7) electric log no  
 (yes or no)  
N/A  
 (organization running log)
- (8) how well bottom plugged BWU

DRILLERS REMARKS: N/A

175  
280

If well telescopes please sketch and show depths.

GROUND LEVEL

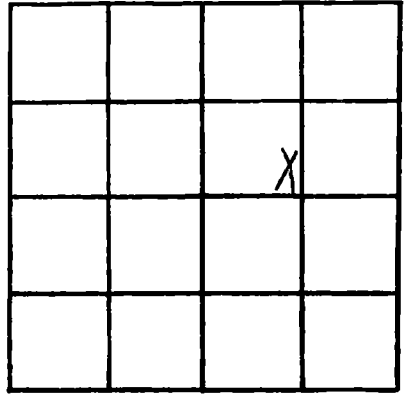

SECTION 7

Please indicate well location X.

ADDITIONAL INFORMATION

If more than one screen, show locations of each on sketch.