

MISSISSIPPI DEPARTMENT OF NATURAL RESOURCES

Bureau of Land and Water Resources

Southport Mall

P.O. Box 10631

Jackson, Mississippi 39209

WATER WELL DRILLERS LOG

Hancock
K 2561

11-15-84 19
date well completed

Mc Mill Well Work
firm name

Hancock
county well located

LANDOWNER: Martin Pawley

P.O. Box 108

Pass Chr, Mo. 39571
(mailing address)

WELL LOCATION:

sec. 22 T. 8 N. R. 18 E. 14 S.

6 miles N of P.C
(distance) (direction) (nearest town)

WELL PURPOSE:

(home, irrigation, municipal, industrial)

WELL COMPLETION DATA:

- (1) diameter (inches) 2"
- (2) total depth (feet) 520'
- (3) static water level (feet) 40' below top of ground.
- (4) casing sch 40 PVC (material), 510' (depth)

 (size) If telescope see back.

- (5) screen 10' (length), 510' (depth to top)
- 2" (size), sch 20 10 slot (material)

- (6) pump 1 (HP), 9 (yield gpm)
- elec (type power)

- (7) electric log (yes or no)

 (organization running log)

- (8) how well bottom plugged Seal

Description of formations encountered

from to

Sand	0	20
Sand & Gravel	20	60
Gravel	60	80
Gravel & mud	80	100
mud	100	120
mud & sand	120	140
mud	140	220
mud & sand	220	240
sand	240	260
mud & mud	260	280
mud	280	320
sand & mud	320	360
mud	360	400
mud & sand	400	460
mud	460	480
Sand & gravel	480	520

DRILLERS REMARKS:


DEPT. OF NATURAL RESOURCES
BUREAU OF LAND & WATER RESOURCES

DEC - 8 1984

RECEIVED

If well telescopes please sketch and show depths.

GROUND LEVEL

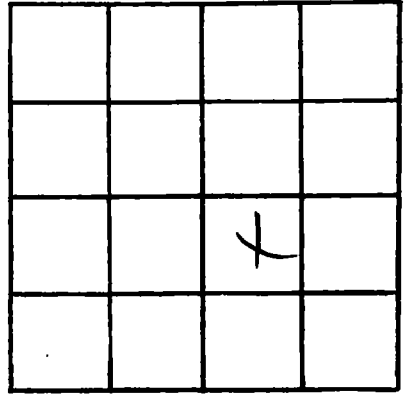

SECTION _____

Please indicate well location X.

ADDITIONAL INFORMATION

If more than one screen, show locations of each on sketch.