

Hancock
R-2563

MISSISSIPPI DEPARTMENT OF NATURAL RESOURCES
 Bureau of Land and Water Resources
 Southport Mall
 P.O. Box 10631
 Jackson, Mississippi 39209
WATER WELL DRILLERS LOG

11-26- 1984 Ward Well Dr. Hancock
 date well completed firm name county well located

LANDOWNER: Eugene Davis
Good St.
Bay St. Davis, Mrs.
 (mailing address)

description of formations encountered	from	to
	<u>fill-clay</u>	<u>0</u>
<u>Sd</u>	<u>20</u>	<u>36</u>
<u>clay</u>	<u>36</u>	<u>94</u>
<u>Sd</u>	<u>94</u>	<u>128</u>
<u>cone Sd</u>	<u>128</u>	<u>140</u>

WELL LOCATION:
 sec. 26 T-8 N R-13 E
3 miles NW of B.S.L.
 (distance) (direction) (nearest town)

WELL PURPOSE: Home
 (home, irrigation, municipal, industrial)


- WELL COMPLETION DATA:
- diameter (inches) 2"
 - total depth (feet) 140
 - static water level (feet) 4 below top of ground. above
 - casing PVC, 130'
 (material) (depth)
 (size) if telescope see back.
 - screen 10' -
 (length) (depth to top)
2" PVC
 (size) (material)
 - pump Orinco -
 (HP) (yield gpm)
 (type power)
 - electric log NO
 (yes or no)
N/A
 (organization running log)
 - how well bottom plugged BWU

DRILLERS REMARKS: N/A

1-22-85
JW

If well telescopes please sketch and show depths.

GROUND LEVEL

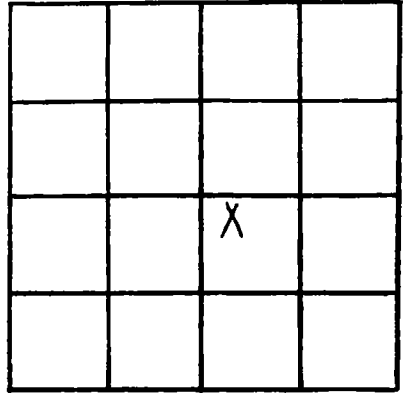

SECTION 26

Please indicate well location X.

ADDITIONAL INFORMATION

If more than one screen,
show locations of each on sketch.