

MISSISSIPPI DEPARTMENT OF NATURAL RESOURCES

Bureau of Land and Water Resources

Southport Mall

P.O. Box 10631

Jackson, Mississippi 39209

WATER WELL DRILLERS LOG

HANCOCK
K 2564
12-19-84

12-19-1984 date well completed 8th Ward Well Dly firm name Hancock county well located

LANDOWNER: Albert Walker
West Kempton
Bay St. Louis, ms.
(mailing address)

WELL LOCATION:
sec 6 T 9 N R 14 E
6 miles West of Waveland
(distance) (direction) (nearest town)

WELL PURPOSE: Home
(home, irrigation, municipal, industrial)

WELL COMPLETION DATA:

(1) diameter (inches) 2"
(2) total depth (feet) 168
(3) static water level (feet) 12 below top of ground.
(4) casing PVC, 158',
(material) (depth)
 if telescope see back.
(size)
(5) screen 10',
(length) (depth to top)
2", PVC
(size) (material)
(6) pump owner
(HP) (yield gpm)

(type power)
(7) electric log NO
(yes or no)
N/A
(organization running log)
(8) how well bottom plugged BWV

description of formations encountered	from	to
Clay	0	14
Clay sd	14	42
Clay	42	94
sd	94	128
Clay-Silt	128	154
Red Shale-sd	154	168


RECEIVED
MAR 28 1985

Department of Natural Resources
Bureau of Land & Water Resources

DRILLERS REMARKS: N/A

If well telescopes please sketch and show depths.

GROUND LEVEL

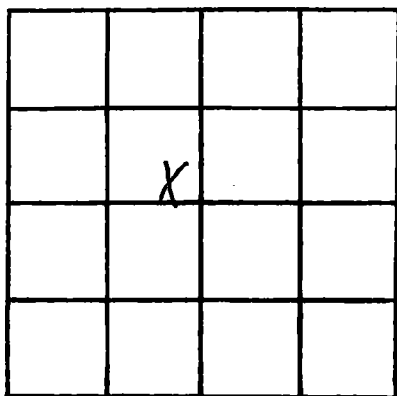

SECTION 6

Please indicate well location X.

ADDITIONAL INFORMATION

If more than one screen, show locations of each on sketch.