

HANCOCK CO.  
 K 2566  
 1-1-85

MISSISSIPPI DEPARTMENT OF NATURAL RESOURCES  
 Bureau of Land and Water Resources  
 Southport Mall  
 P.O. Box 10631  
 Jackson, Mississippi 39209  
 WATER WELL DRILLERS LOG

1-7-85 date well completed      1985 Ward Well Dg. firm name      Hancock county well located

LANDOWNER: Anthony Haro  
 Rt. 7, Box 179F  
 Bay St. Louis, ms.  
 (mailing address)

description of formations encountered	from	to
Clay	0	15
sd	15	42
Clay	42	95
sd	95	132
Clay - Shell	132	148
Red Shell sd	148	165

WELL LOCATION:  
 sec. 6 T. 9 N. R. 14 E.  
 7 miles W of Waveland  
 (distance) (direction) (nearest town)

WELL PURPOSE: None  
 (home, irrigation, municipal, industrial)

- WELL COMPLETION DATA:
- diameter (inches) 2"
  - total depth (feet) 165
  - static water level (feet) 12 <sup>below</sup>/<sub>above</sub> top of ground.
  - casing PVC, 155  
 (material) (depth)  
 (size) If telescope see back.
  - screen 10', -  
 (length) (depth to top)  
2", PVC  
 (size) (material)
  - pump owner, -  
 (HP) (yield gpm)  
 (type power)
  - electric log NO  
 (yes or no)  
N/A  
 (organization running log)
  - how well bottom plugged BWU


DRILLERS REMARKS: N/A

RECEIVED  
 MAR 28 1985

Department of Natural Resources  
 Bureau of Land & Water Resources

If well telescopes please sketch and show depths.

GROUND LEVEL

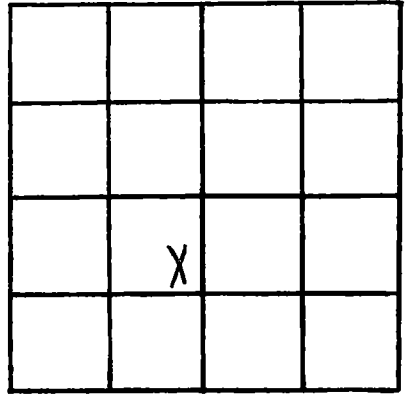

SECTION 6

Please indicate well location X.

ADDITIONAL INFORMATION

If more than one screen, show locations of each on sketch.