

MISSISSIPPI DEPARTMENT OF NATURAL RESOURCES

Bureau of Land and Water Resources

Southport Mall

P.O. Box 10631

Jackson, Mississippi 39209

WATER WELL DRILLERS LOG

Hancock Co
K2567
1-8-85

Jan. 8 1985 date well completed
Wood Well Dr. firm name
Hancock county well located

LANDOWNER: Charles Hamrick
Cal. St.
Bay St. John Mrs.
(mailing address)
WELL LOCATION:
sec. 28 T. 8 N. R. 13 E. 14
10 miles N/W of Waveland
(distance) (direction) (nearest town)
WELL PURPOSE: None
(home, irrigation, municipal, industrial)

description of formations encountered	from	to
	<u>fill - clay</u>	<u>0</u>
<u>sd</u>	<u>18</u>	<u>45</u>
<u>clay - silt</u>	<u>45</u>	<u>86</u>
<u>sd</u>	<u>86</u>	<u>94</u>
<u>clay - silt</u>	<u>94</u>	<u>145</u>
<u>fine sd</u>	<u>145</u>	<u>172</u>
<u>clay</u>	<u>172</u>	<u>198</u>
<u>sd</u>	<u>198</u>	<u>226</u>

WELL COMPLETION DATA:

(1) diameter (inches) 2"

(2) total depth (feet) 226

(3) static water level (feet) 2 below above top of ground.

(4) casing 2" 216
(material) (depth)
- If telescope see back.
(size)

(5) screen 10' -
(length) (depth to top)
2" PVC
(size) (material)

(6) pump owner -
(HP) (yield gpm)
-
(type power)

(7) electric log no
(yes or no)
N/A
(organization running log)

(8) how well bottom plugged BWV.


DRILLERS REMARKS: N/A

RECEIVED
MAR 28 1985

Department of Natural Resources
Bureau of Land & Water Resources

If well telescopes please sketch and show depths.

GROUND LEVEL

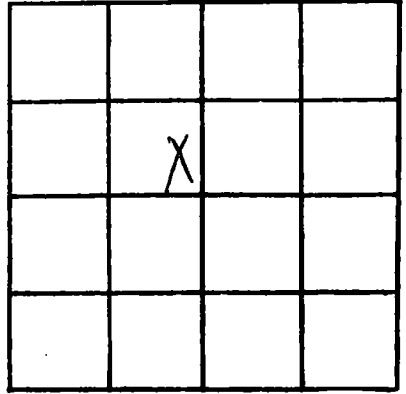

SECTION 28

Please indicate well location X.

ADDITIONAL INFORMATION

If more than one screen, show locations of each on sketch.