

MISSISSIPPI DEPARTMENT OF NATURAL RESOURCES

Bureau of Land and Water Resources

Southport Mall

P.O. Box 10631

Jackson, Mississippi 39209

WATER WELL DRILLERS LOG

Hancock
K2570
1-16-85

Jan. 16 1985 date well completed
Ward Well Drg. firm name
Hancock county well located

LANDOWNER: Francis Whiting
Dove St.
Bay St. Louis, ms.
(mailing address)

WELL LOCATION:
sec. 22 T. 8 N. R. 13 E
6 miles NW of B.S.L.
(distance) (direction) (nearest town)

WELL PURPOSE: Home
(home, irrigation, municipal, industrial)

WELL COMPLETION DATA:

(1) diameter (inches) 2"

(2) total depth (feet) 420

(3) static water level (feet) 1 ^{below} _{above} top of ground.

(4) casing PVC, 410,
(material) (depth)
 if telescope see back.
(size)

(5) screen 10,
(length) (depth to top)
2", PVC
(size) (material)

(6) pump ,
(HP) (yield gpm)

(type power)

(7) electric log NO
(yes or no)
N/A
(organization running log)

(8) how well bottom plugged BWV

description of formations encountered	from	to
Clay	0	16
SS	16	48
Clay	48	96
fine ss	96	118
Clay-silt	118	154
fine ss	154	172
Clay-silt	172	260
fine ss	260	285
Clay-silt	285	370
Coarse ss	370	420


RECEIVED
MAR 28 1985

DRILLERS REMARKS: N/A

Department of Natural Resources
Bureau of Land & Water Resources

If well telescopes please sketch and show depths.

GROUND LEVEL

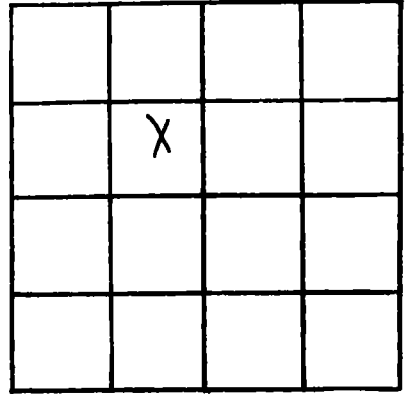

SECTION 6

Please indicate well location X.

ADDITIONAL INFORMATION

If more than one screen, show locations of each on sketch.