

MISSISSIPPI DEPARTMENT OF NATURAL RESOURCES

Bureau of Land and Water Resources

Southport Mall

P.O. Box 10631

Jackson, Mississippi 39209

WATER WELL DRILLERS LOG

K ~~426~~ 2571
 HANCOCK
 1-26-85

Jan. 26 1985 Ward Well Dr. Hancock
 date well completed firm name county well located

LANDOWNER: Raymond Venezia
 Rt. 7, Box 216 A
 Bay St. Louis, ms.
 (mailing address)

description of formations encountered	from	to
Top Soil - clay	0	14
sd	14	44
clay	44	95
sd	95	128
clay - shell	128	150
Red Shell - sd	150	168

WELL LOCATION:
 sec. 6 T 9 N R 14 E
 7 miles W of Waveland
 (distance) (direction) (nearest town)

WELL PURPOSE: Home
 (home, irrigation, municipal, industrial)

WELL COMPLETION DATA:

- (1) diameter (inches) 2"
- (2) total depth (feet) 168
- (3) static water level (feet) 12 below above top of ground.
- (4) casing PVC, 158, (material) (depth)
- (size) If telescope see back.
- (5) screen 10' (length) (depth to top)
- (size) PVC (material)
- (6) pump orner (HP) (yield gpm)
- (type power)
- (7) electric log NO (yes or no)
- N/A (organization running log)
- (8) how well bottom plugged BWV

RECEIVED


APR 10 1985

DRILLERS REMARKS: N/A

Department of Natural Resources
 Bureau of Land & Water Resources

If well telescopes please sketch and show depths.

GROUND LEVEL

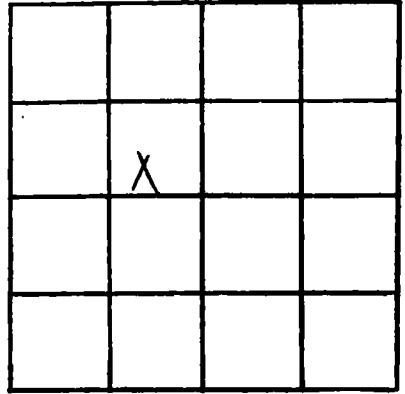

SECTION 6

Please indicate well location X.

ADDITIONAL INFORMATION

If more than one screen,
show locations of each on sketch.