

MISSISSIPPI DEPARTMENT OF NATURAL RESOURCES

Bureau of Land and Water Resources

Southport Mall

P.O. Box 10631

Jackson, Mississippi 39209

WATER WELL DRILLERS LOG

K ~~2572~~ 2572
 HANCOCK
 2-15-85

Feb. 15 1985 Ward Well Dly. Hancock
 date well completed firm name county well located

LANDOWNER: Alyson O. Roane
Central & 6 St.
Bay St. Louis, ms.
 (mailing address)

description of formations encountered	from	to
Clay	0	15
Sd	15	45
Clay - Silt	45	98
Hard Sd	98	112
Clay - Silt	112	147
Sd	147	170

WELL LOCATION: 14.
 sec. 28 T. 8 N. R. 18 E.
6 miles N/W of Waveland
 (distance) (direction) (nearest town)

WELL PURPOSE: Home
 (home, irrigation, municipal, industrial)

WELL COMPLETION DATA:

(1) diameter (inches) 2"
 (2) total depth (feet) 170
 (3) static water level (feet) 8 below above top of ground.
 (4) casing PVC, 160,
 (material) (depth)
- If telescope see back.
 (size)
 (5) screen 10', -
 (length) (depth to top)
2", PVC
 (size) (material)
 (6) pump -, -
 (HP) (yield gpm)
-
 (type power)
 (7) electric log No
 (yes or no)
N/A
 (organization running log)
 (8) how well bottom plugged BWU


RECEIVED
 APR 10 1985

DRILLERS REMARKS: N/A

Department of Natural Resources
 Bureau of Land & Water Resources

If well telescopes please sketch and show depths.

GROUND LEVEL

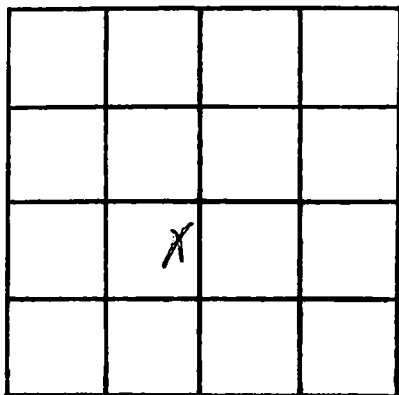

SECTION 28

Please indicate well location X.

ADDITIONAL INFORMATION

If more than one screen,
show locations of each on sketch.