

MISSISSIPPI DEPARTMENT OF NATURAL RESOURCES

Bureau of Land and Water Resources

Southport Mall

P.O. Box 10631

Jackson, Mississippi 39209

WATER WELL DRILLERS LOG

~~K 2573~~
HANCOCK
2-20-85

Feb. 20 1985 Ward Well Drg. Hancock
date well completed firm name county well located

LANDOWNER: Joseph E. Bondarp.
Saleshore Rd.
Boy St. Sain, Mrs.
(mailing address)

WELL LOCATION:
sec. 22 T-8 N R-14 E
1 miles S of Tubular
(distance) (direction) (nearest town)

WELL PURPOSE: Home
(home, irrigation, municipal, industrial)

- WELL COMPLETION DATA:
- (1) diameter (inches) 2"
 - (2) total depth (feet) 290'
 - (3) static water level (feet) 8' ^{below} top of ground.
 - (4) casing PVC, 280' (material) (depth)
If telescope see back.
 - (5) screen 10' (length) (depth to top)
2" (size) PVC (material)
 - (6) pump 1/2 (HP) 10 (yield gpm)
Elec. (type power)
 - (7) electric log NO (yes or no)
N/A (organization running log)
 - (8) how well bottom plugged BWV

description of formations encountered	from	to
fill-clay	0	12
sd	12	46
clay-silt	46	110
Red Shale-sd	110	142
clay-silt	142	265
sd	265	290


RECEIVED
APR 10 1985

DRILLERS REMARKS: N/A

Department of Natural Resources
Bureau of Land & Water Resources

If well telescopes please sketch and show depths.

GROUND LEVEL

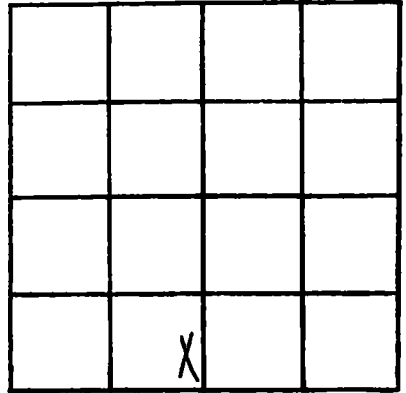

SECTION 22

Please indicate well location X.

ADDITIONAL INFORMATION

If more than one screen,
show locations of each on sketch.