

MISSISSIPPI DEPARTMENT OF NATURAL RESOURCES

Bureau of Land and Water Resources

Southport Mall

P.O. Box 10631

Jackson, Mississippi 39209

WATER WELL DRILLERS LOG

~~K 2574~~  
 HANCOCK  
 2-22-85

Feb. 22 1985 Ward Well Dly Hancock  
 date well completed firm name county well located

LANDOWNER: Paul Jolley  
 Paradise Lane  
 Bay St. Louis, ms.  
 (mailing address)

description of formations encountered	from	to
Fill-clay	0	18
sd	18	42
Red gravel - sd	42	236
Clay - sd	236	374
sd	374	405
Clay - silt	405	526
coral sd	526	585

WELL LOCATION:  
 sec. 26 T. 4 N R. 13 E  
 3 miles N/W of B.S.L.  
 (distance) (direction) (nearest town)

WELL PURPOSE: Home  
 (home, irrigation, municipal, industrial)

- WELL COMPLETION DATA:
- (1) diameter (inches) 2"
  - (2) total depth (feet) 585
  - (3) static water level (feet) 5 below top of ground
  - (4) casing PVC 565 (material) (depth)
  - (size) If telescope see back.
  - (5) screen 20' (length) (depth to top)
  - 2" (size) PVC (material)
  - (6) pump owner (HP) (yield gpm)
  - (type power)
  - (7) electric log NO (yes or no)
  - N/A (organization running log)
  - (8) how well bottom plugged BWV

RECEIVED


APR 10 1985

Department of Natural Resources  
 Bureau of Land & Water Resources

DRILLERS REMARKS: N/A

If well telescopes please sketch and show depths.

GROUND LEVEL

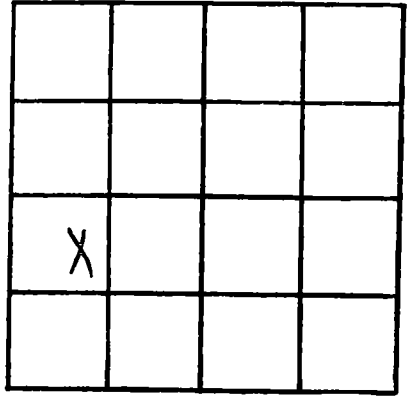

SECTION 26

Please indicate well location X.

ADDITIONAL INFORMATION

If more than one screen, show locations of each on sketch.