

Hancock  
K 2575

MISSISSIPPI DEPARTMENT OF NATURAL RESOURCES  
Bureau of Land and Water Resources  
Southport Mall  
P.O. Box 10631  
Jackson, Mississippi 39209  
WATER WELL DRILLERS LOG

4-4-1985 date well completed  
85 Ward Well Dr. firm name  
Hancock Co. county well located

LANDOWNER: John Mason  
Dolphin St.  
Boy St. Loring, Mr.  
(mailing address)

description of formations encountered	from	to
	fill-clay	0
sd	15	42
clay	42	74
bsd	74	82
clay	82	105
sd	105	116
clay	116	148
sd	148	165

WELL LOCATION:  
sec. 28 T 8 N R 13 E 14  
6 miles N of Waveland  
(distance) (direction) (nearest town)

WELL PURPOSE: Home  
(home, irrigation, municipal, industrial)

WELL COMPLETION DATA:

(1) diameter (inches) 2"

(2) total depth (feet) 165

(3) static water level (feet) 5 below top of ground.

(4) casing PVC, 155 (material) (depth)  
If telescope see back.

(5) screen 10' (length) (depth to top)  
2" PVC (size) (material)

(6) pump ormer (HP) (yield gpm)  
Elec. (type power)

(7) electric log no. (yes or no)  
N/A (organization running log)

(8) how well bottom plugged BWV


RECEIVED  
JUN 27 1985

DRILLERS REMARKS: N/A

Department of Natural Resources  
Bureau of Land & Water Resources

If well telescopes please sketch and show depths.

GROUND LEVEL

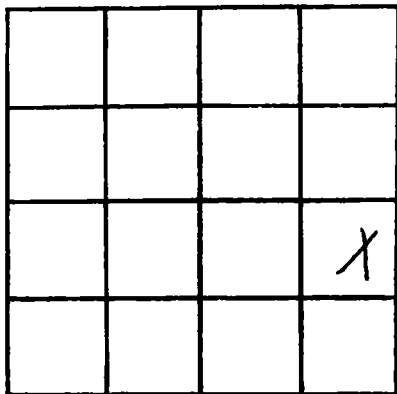

SECTION 28

Please indicate well location X.

**ADDITIONAL INFORMATION**

A series of horizontal lines for writing additional information, starting below the 'ADDITIONAL INFORMATION' header and extending to the bottom of the page.

If more than one screen, show locations of each on sketch.