

Hancock
 K 2576
 4-8-85

MISSISSIPPI DEPARTMENT OF NATURAL RESOURCES
 Bureau of Land and Water Resources
 Southport Mall
 P.O. Box 10631
 Jackson, Mississippi 39209
WATER WELL DRILLERS LOG

4-8-1985 date well completed
 Ward Well Pkg. firm name
 Hancock county well located

LANDOWNER: J.C. Wells
 Eden St.
 Bay St. Louis, Mo.
 (mailing address)

description of formations encountered	from	to
	Fill - clay	0
sd	18	37
clay - silt	37	104
Fill - sd	104	115
clay	115	126
sd	126	145

WELL LOCATION:
 sec. 40 T-8 N R-13 E-14
 7 miles N/W of Warland
 (distance) (direction) (nearest town)

WELL PURPOSE: Home
 (home, irrigation, municipal, industrial)

- WELL COMPLETION DATA:
- (1) diameter (inches) 2"
 - (2) total depth (feet) 145
 - (3) static water level (feet) 6 below top of ground.
 - (4) casing PVC, 135 (material) (depth)
 (size) if telescope see back.
 - (5) screen 10' (length) (depth to top)
 2" (size) PVC (material)
 - (6) pump 1/2 (HP) 10 (yield gpm)
 Elec. (type power)
 - (7) electric log NO (yes or no)
 N/A (organization running log)
 - (8) how well bottom plugged BWV


DRILLERS REMARKS: N/A

RECEIVED
 JUN 17 1985

Department of Natural Resources
 Bureau of Land & Water Resources

If well telescopes please sketch and show depths.

GROUND LEVEL

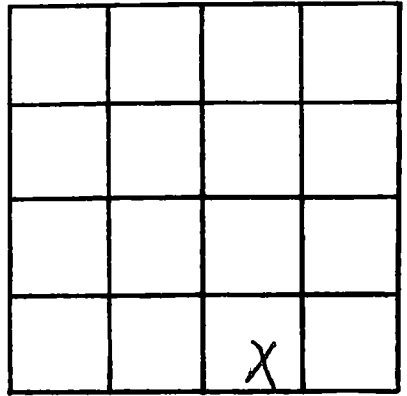

SECTION _____

Please indicate well location X.

ADDITIONAL INFORMATION

If more than one screen,
show locations of each on sketch.