

MISSISSIPPI DEPARTMENT OF NATURAL RESOURCES

Bureau of Land and Water Resources

Southport Mall

P.O. Box 10631

Jackson, Mississippi 39209

WATER WELL DRILLERS LOG

HANCOCK
K 2577

4/10 1985 Bradley Pump & Well Hancock
 date well completed firm name county well located

LANDOWNER: Andrew Schmidt
P.O. Box 466
Arabi, La. 70032
 (mailing address)

WELL LOCATION:
 sec. 26 T. 8 N. R. 14 E.
1 miles NW of Bay St. Louis
 (distance) (direction) (nearest town)

WELL PURPOSE: Home
 (home, irrigation, municipal, industrial)

WELL COMPLETION DATA:

(1) diameter (inches) 2"

(2) total depth (feet) 360'

(3) static water level (feet) 1 below above top of ground.

(4) casing PVC, 340
 (material) (depth)
2" if telescope see back.
 (size)

(5) screen 10', 340
 (length) (depth to top)
2", PVC
 (size) (material)

(6) pump 1/2 (HP) (yield gpm)
230V ϕ
 (type power)

(7) electric log no
 (yes or no)

(organization running log)

(8) how well bottom plugged PVC
sandshank

description of formations encountered	from	to
<u>sand + clay</u>	<u>0</u>	<u>40</u>
<u>sand + gravel</u>	<u>40</u>	<u>60</u>
<u>sand + clay</u>	<u>60</u>	<u>200</u>
<u>clay</u>	<u>200</u>	<u>220</u>
<u>clay + sand</u>	<u>220</u>	<u>280</u>
<u>sand</u>	<u>280</u>	<u>360</u>

DRILLERS REMARKS: 10 ft
tailpipe


RECEIVED
 APR 23 1985

Department of Natural Resources
 Bureau of Land & Water Resources

If well telescopes please sketch and show depths.

Cannot be plotted - streets are not on county map.

GROUND LEVEL

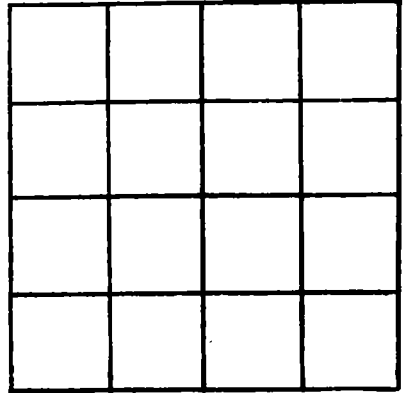

SECTION 26

Please indicate well location X.

ADDITIONAL INFORMATION

If more than one screen, show locations of each on sketch.