

Hancock  
K 2578  
4-12-85

MISSISSIPPI DEPARTMENT OF NATURAL RESOURCES  
Bureau of Land and Water Resources  
Southport Mall  
P.O. Box 10631  
Jackson, Mississippi 39209  
WATER WELL DRILLERS LOG

4-12-1985 date well completed      Ward Well Digs firm name      Hancock county well located

LANDOWNER: Buddy Noman  
Petate Acres  
Ansley, Miss.  
(mailing address)

| description of formations encountered | from       | to         |
|---------------------------------------|------------|------------|
| <u>Fill-clay</u>                      | <u>0</u>   | <u>18</u>  |
| <u>Sd</u>                             | <u>18</u>  | <u>45</u>  |
| <u>Clay-shell</u>                     | <u>45</u>  | <u>87</u>  |
| <u>Clay</u>                           | <u>87</u>  | <u>104</u> |
| <u>Sd-Rock</u>                        | <u>104</u> | <u>126</u> |

WELL LOCATION:  
sec. 20 T. 9 N. R. 14 E.  
13 miles S/W of Jakobae  
(distance) (direction) (nearest town)

WELL PURPOSE: Home  
(home, irrigation, municipal, industrial)

- WELL COMPLETION DATA:
- (1) diameter (inches) 2"
  - (2) total depth (feet) 126'
  - (3) static water level (feet) 10 <sup>below</sup> <sub>above</sub> top of ground.
  - (4) casing PVC, 116'  
(material) (depth)  
- If telescope see back.  
(size)
  - (5) screen 10', -  
(length) (depth to top)  
2", PVC  
(size) (material)
  - (6) pump owner, -  
(HP) (yield gpm)  
- (type power)
  - (7) electric log NO  
(yes or no)  
N/A  
(organization running log)
  - (8) how well bottom plugged BWD


DRILLERS REMARKS: N/A

RECEIVED  
JUN 17 1985

Department of Natural Resources  
Bureau of Land & Water Resources

If well telescopes please sketch and show depths.

GROUND LEVEL

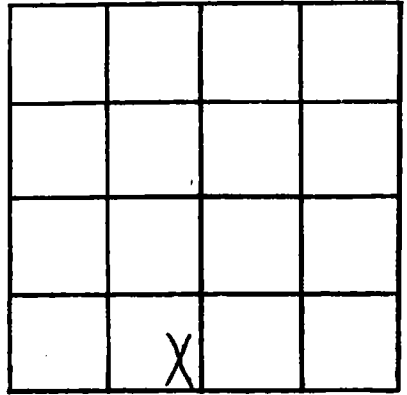

SECTION 20

Please indicate well location X.

ADDITIONAL INFORMATION

If more than one screen, show locations of each on sketch.