

MISSISSIPPI DEPARTMENT OF NATURAL RESOURCES

Bureau of Land and Water Resources

Southport Mall

P.O. Box 10631

Jackson, Mississippi 39209

WATER WELL DRILLERS LOG

Harroch
K 2580
4-16-85

4-16 1985 Ward Well Dly. Harroch
 date well completed firm name county well located

LANDOWNER: BCCO Construction
P.O. Box 655
Bay St. Louis, ms.
 (mailing address)

WELL LOCATION:
 sec. 23 T. 8 N R. 12 E 4
6 miles N/W of B.S.L.
 (distance) (direction) (nearest town)

WELL PURPOSE: None
 (home, irrigation, municipal, industrial)

WELL COMPLETION DATA:

(1) diameter (inches) 2'

(2) total depth (feet) 170

(3) static water level (feet) 8 ^{below} above top of ground.

(4) casing PVC, 160
 (material) (depth)
 (size) if telescope see back.

(5) screen 10', -
 (length) (depth to top)
2", PVC
 (size) (material)

(6) pump none, -
 (HP) (yield gpm)
 (type power)

(7) electric log no
 (yes or no)
N/A
 (organization running log)

(8) how well bottom plugged 3WU

description of formations encountered	from	to
	<u>fill - clay</u>	<u>0</u>
<u>sd</u>	<u>18</u>	<u>47</u>
<u>clay - silt</u>	<u>47</u>	<u>96</u>
<u>flint - sd</u>	<u>96</u>	<u>112</u>
<u>clay - silt</u>	<u>112</u>	<u>152</u>
<u>sd</u>	<u>152</u>	<u>170</u>

DRILLERS REMARKS: N/A


RECEIVED
 JUN 17 1985

Department of Natural Resources
 Bureau of Land & Water Resources

If well telescopes please sketch and show depths.

15

GROUND LEVEL

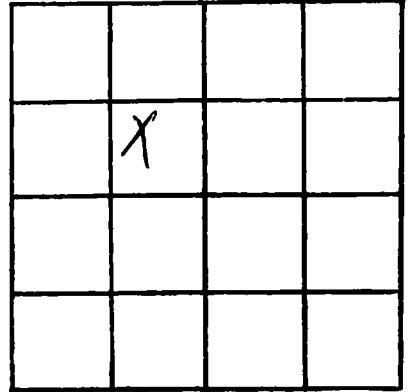

SECTION 22

Please indicate well location X.

ADDITIONAL INFORMATION

If more than one screen, show locations of each on sketch.