

Hancock
 K 25 81
 4-18-85

MISSISSIPPI DEPARTMENT OF NATURAL RESOURCES
 Bureau of Land and Water Resources
 Southport Mall
 P.O. Box 10631
 Jackson, Mississippi 39209
WATER WELL DRILLERS LOG

4-18-85 date well completed
 85 Ward Well Dg. firm name
 Hancock county well located

LANDOWNER: Olivia Melton
Coral St.
Bay St. Louis, ms.
 (mailing address)

description of formations encountered	from	to
	<u>fill - clay</u>	<u>0</u>
<u>sd</u>	<u>15</u>	<u>45</u>
<u>clay - shell</u>	<u>45</u>	<u>62</u>
<u>clay - silt</u>	<u>62</u>	<u>110</u>
<u>sd</u>	<u>110</u>	<u>150</u>

WELL LOCATION:
 sec. 33 T. 8 N. R. 17 E. 14
4 miles N of Waveland
 (distance) (direction) (nearest town)

WELL PURPOSE: Home
 (home, irrigation, municipal, industrial)

- WELL COMPLETION DATA:
- (1) diameter (inches) 2"
 - (2) total depth (feet) 150'
 - (3) static water level (feet) 8 ^{below} _{above} top of ground.
 - (4) casing PVC, 140,
 (material) (depth)
- if telescope see back.
 (size)
 - (5) screen 10', -
 (length) (depth to top)
2", PVC
 (size) (material)
 - (6) pump owner, -
 (HP) (yield gpm)
-
 (type power)
 - (7) electric log NO
 (yes or no)
N/A
 (organization running log)
 - (8) how well bottom plugged BWD


DRILLERS REMARKS: N/A

RECEIVED
 JUN 17 1985

Department of Natural Resources
 Bureau of Land & Water Resources

If well telescopes please sketch and show depths.

GROUND LEVEL

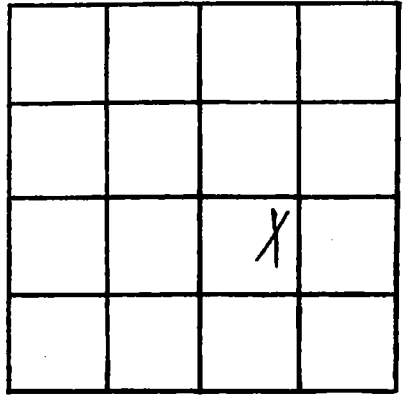

SECTION 33

Please indicate well location X.

ADDITIONAL INFORMATION

If more than one screen, show locations of each on sketch.