

Hancock
K 25 82

MISSISSIPPI DEPARTMENT OF NATURAL RESOURCES
Bureau of Land and Water Resources
Southport Mall
P.O. Box 10631
Jackson, Mississippi 39209
WATER WELL DRILLERS LOG

4-25-1985 date well completed Wood Well Drilling firm name Hancock county well located

LANDOWNER: Mrs. Herman Rice
West Perry St.
Bay St. Loring, Mo.
(mailing address)

description of formations encountered	from	to
F.S. clay	0	18
clay-shell	18	52
SS	52	95
clay-shell	95	132
Red Shale - SS	132	164
	164	180

WELL LOCATION:
sec. 6 T. 9 N. R. 14 E.
7 miles W of Webb
(distance) (direction) (nearest town)

WELL PURPOSE: Home
(home, irrigation, municipal, industrial)

- WELL COMPLETION DATA:
- (1) diameter (inches) 2"
 - (2) total depth (feet) 180'
 - (3) static water level (feet) 12' below top of ground
 - (4) casing PVC, 120' (material) (depth)
 - (size) If telescope see back.
 - (5) screen 10' (length) (depth to top)
 - 2" (size) PVC (material)
 - (6) pump none (HP) (yield gpm)
 - (type power)
 - (7) electric log NO (yes or no)
 - N/A (organization running log)
 - (8) how well bottom plugged BWD


RECEIVED
JUN 17 1985

DRILLERS REMARKS: N/A

Department of Natural Resources
Bureau of Land & Water Resources

If well telescopes please sketch and show depths.

GROUND LEVEL

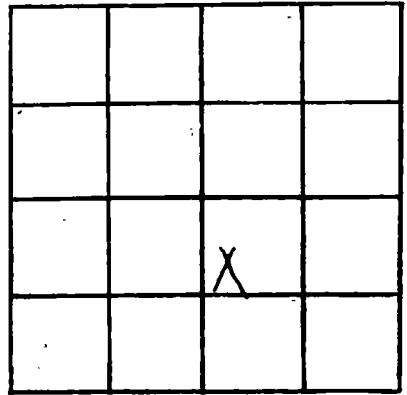

SECTION 6

Please indicate well location X.

ADDITIONAL INFORMATION

If more than one screen,
show locations of each on sketch.