

MISSISSIPPI DEPARTMENT OF NATURAL RESOURCES

Bureau of Land and Water Resources

Southport Mall

P.O. Box 10631

Jackson, Mississippi 39209

WATER WELL DRILLERS LOG

Hancock  
K 2583  
5-1-85

L

5-1-85 date well completed      85 WARD WELL DRG. firm name      Hancock county well located

LANDOWNER: marsh A. Flythe  
Rt. 2, Box 256  
Bay St. Louis, ms.  
(mailing address)

description of formations encountered	from	to
Fill - Clay	0	12
sd	12	36
Clay	36	85
sd	85	110
Clay - silt	110	164
sd	164	182

WELL LOCATION:  
sec 31 T 8 N R 13 E  
7 miles N/W of Waveland  
(distance) (direction) (nearest town)

WELL PURPOSE: Home  
(home, irrigation, municipal, industrial)

- WELL COMPLETION DATA:
- (1) diameter (inches) 2"
  - (2) total depth (feet) 182'
  - (3) static water level (feet) 3 <sup>below</sup> <sub>above</sub> top of ground.
  - (4) casing PVC, 172  
(material) (depth)  
- If telescope see back.  
(size)
  - (5) screen 10', -  
(length) (depth to top)  
2", PVC  
(size) (material)
  - (6) pump owner, -  
(HP) (yield gpm)  
-  
(type power)
  - (7) electric log NO  
(yes or no)  
N/A  
(organization running log)
  - (8) how well bottom plugged BWU

RECEIVED


JUL 12 1985

Department of Natural Resources  
Bureau of Land & Water Resources

DRILLERS REMARKS: N/A

If well telescopes please sketch and show depths.

GROUND LEVEL

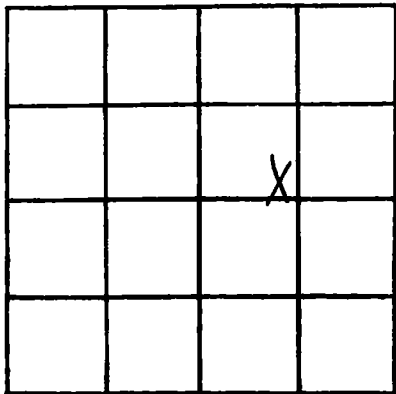

SECTION 31

Please indicate well location X.

ADDITIONAL INFORMATION

Lined area for additional information.

If more than one screen, show locations of each on sketch.