

Hancock
K 2584
5-2-85

MISSISSIPPI DEPARTMENT OF NATURAL RESOURCES
Bureau of Land and Water Resources
Southport Mall
P.O. Box 10631
Jackson, Mississippi 39209
WATER WELL DRILLERS LOG

L

5-2-1985 date well completed 85 WARD WELL OLG. firm name HANCOCK county well located

LANDOWNER: Richard Cook
Central & Seventh St.
Bay St. Louis, Ms.
(mailing address)

description of formations encountered	from	to
<u>fill - clay</u>	<u>0</u>	<u>18</u>
<u>clay</u>	<u>18</u>	<u>44</u>
<u>fine sd</u>	<u>44</u>	<u>96</u>
<u>clay - fill</u>	<u>96</u>	<u>115</u>
<u>sd</u>	<u>115</u>	<u>148</u>
	<u>148</u>	<u>170</u>

WELL LOCATION:
sec. 28 T. 8 N. R. 13 E. 14
6 miles NW of Warland
(distance) (direction) (nearest town)

WELL PURPOSE: Home
(home, irrigation, municipal, industrial)

WELL COMPLETION DATA:

- (1) diameter (inches) 2"
- (2) total depth (feet) 170
- (3) static water level (feet) 6 ^{below} _{above} top of ground.
- (4) casing PVC, 160
(material) (depth)
 if telescope see back.
(size)
- (5) screen 10'
(length) (depth to top)
2" PVC
(size) (material)
- (6) pump owner
(HP) (yield gpm)

(type power)
- (7) electric log NO
(yes or no)
N/A
(organization running log)
- (8) how well bottom plugged BWD


RECEIVED
JUL 12 1985

DRILLERS REMARKS: N/A

Department of Natural Resources
Bureau of Land & Water Resources

If well telescopes please sketch and show depths.

GROUND LEVEL

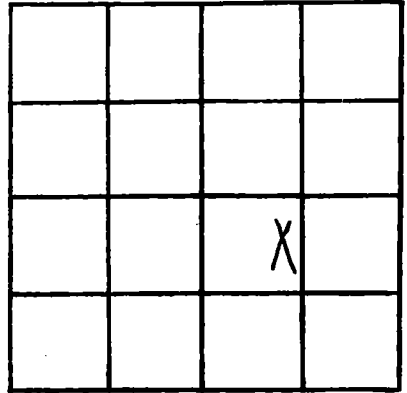

SECTION 28

Please indicate well location X.

ADDITIONAL INFORMATION

If more than one screen,
show locations of each on sketch.