

MISSISSIPPI DEPARTMENT OF NATURAL RESOURCES

Bureau of Land and Water Resources

Southport Mall

P.O. Box 10631

Jackson, Mississippi 39209

WATER WELL DRILLERS LOG

Hancock
K 2587
5-9-85

5-9-1985 date well completed
85 Ward Well Dg. firm name
Hancock county well located

LANDOWNER: Tony Whilden
Virginia St.
Bay St. Louis, Mr.
(mailing address)

description of formations encountered	from	to
Silt - clay	0	18
sd	18	42
clay	42	95
Fine sd	95	112
clay - silt	112	154
sd	154	176

WELL LOCATION:
sec. 39 T 8 N R 13 E 14 W
8 miles N/W of B.S.L.
(distance) (direction) (nearest town)

WELL PURPOSE: Drinking
(home, irrigation, municipal, industrial)

WELL COMPLETION DATA:

(1) diameter (inches) 2"

(2) total depth (feet) 176

(3) static water level (feet) 7 ^{below}/_{above} top of ground.

(4) casing PVC, 166
(material) (depth)

- If telescope see back.
(size)

(5) screen 10', -
(length) (depth to top)

2", PVC
(size) (material)

(6) pump owner -
(HP) (yield gpm)

-
(type power)

(7) electric log no
(yes or no)

N/A
(organization running log)

(8) how well bottom plugged BW


RECEIVED

JUL 12 1985

DRILLERS REMARKS: N/A

If well telescopes please sketch and show depths.

GROUND LEVEL

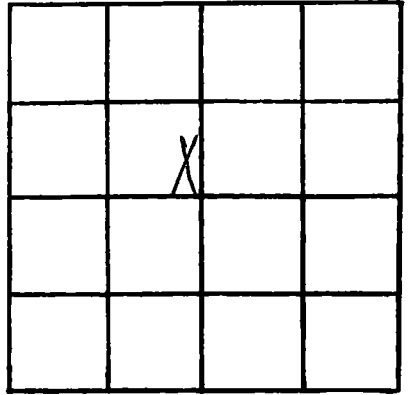

SECTION 39

Please indicate well location X.

ADDITIONAL INFORMATION

If more than one screen,
show locations of each on sketch.