

MISSISSIPPI DEPARTMENT OF NATURAL RESOURCES

Bureau of Land and Water Resources

Southport Mall

P.O. Box 10631

Jackson, Mississippi 39209

WATER WELL DRILLERS LOG

Hancock
K 2588
5-9-85

L

5-9-1985 date well completed Ward Well Dr. firm name Hancock county well located

LANDOWNER: Burne Williamson
Que St.
Bay St. Louis, ms.
 (mailing address)

WELL LOCATION:
 sec. 27 T 8 N R 13 E 14
6 miles N/W of B.S.L.
 (distance) (direction) (nearest town)

WELL PURPOSE:
 (home, irrigation, municipal, industrial)

WELL COMPLETION DATA:

(1) diameter (inches) 2"

(2) total depth (feet) 400

(3) static water level (feet) 1 below top of ground. above

(4) casing PVC 390
 (material) (depth)
— if telescope see back.
 (size)

(5) screen 10' —
 (length) (depth to top)
2" PVC
 (size) (material)

(6) pump Ornu —
 (HP) (yield gpm)
—
 (type power)

(7) electric log NO
 (yes or no)
N/A
 (organization running log)

(8) how well bottom plugged BWV


description of formations encountered	from	to
<u>Clay</u>	<u>0</u>	<u>88</u>
<u>Sd</u>	<u>88</u>	<u>106</u>
<u>Clay - Silt</u>	<u>106</u>	<u>118</u>
<u>Clay</u>	<u>118</u>	<u>152</u>
<u>Flake Sd</u>	<u>152</u>	<u>178</u>
<u>Clay - Silt</u>	<u>178</u>	<u>250</u>
<u>Flake Sd</u>	<u>250</u>	<u>296</u>
<u>Clay - Silt</u>	<u>296</u>	<u>375</u>
<u>Coar Sd</u>	<u>375</u>	<u>400</u>

RECEIVED
 JUL 12 1985

DRILLERS REMARKS: N/A

If well telescopes please sketch and show depths.

GROUND LEVEL

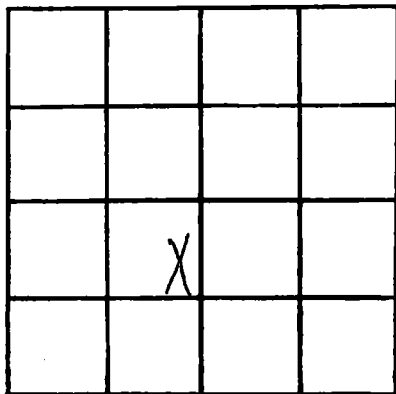

SECTION 27

Please indicate well location X.

ADDITIONAL INFORMATION

If more than one screen, show locations of each on sketch.